

PP

APPROVAL RECORD

Planning Permission


Coimbatore

Coimbatore district, Tamil Nadu

APPROVAL TYPE
Building PlanISSUING AUTHORITY
Town PanchayatPURPOSE
Residential




The approval as the planning authority issued it, reproduced in full behind this page.

An approval speaks to what was sanctioned, not to what was built. Completion is a separate record.

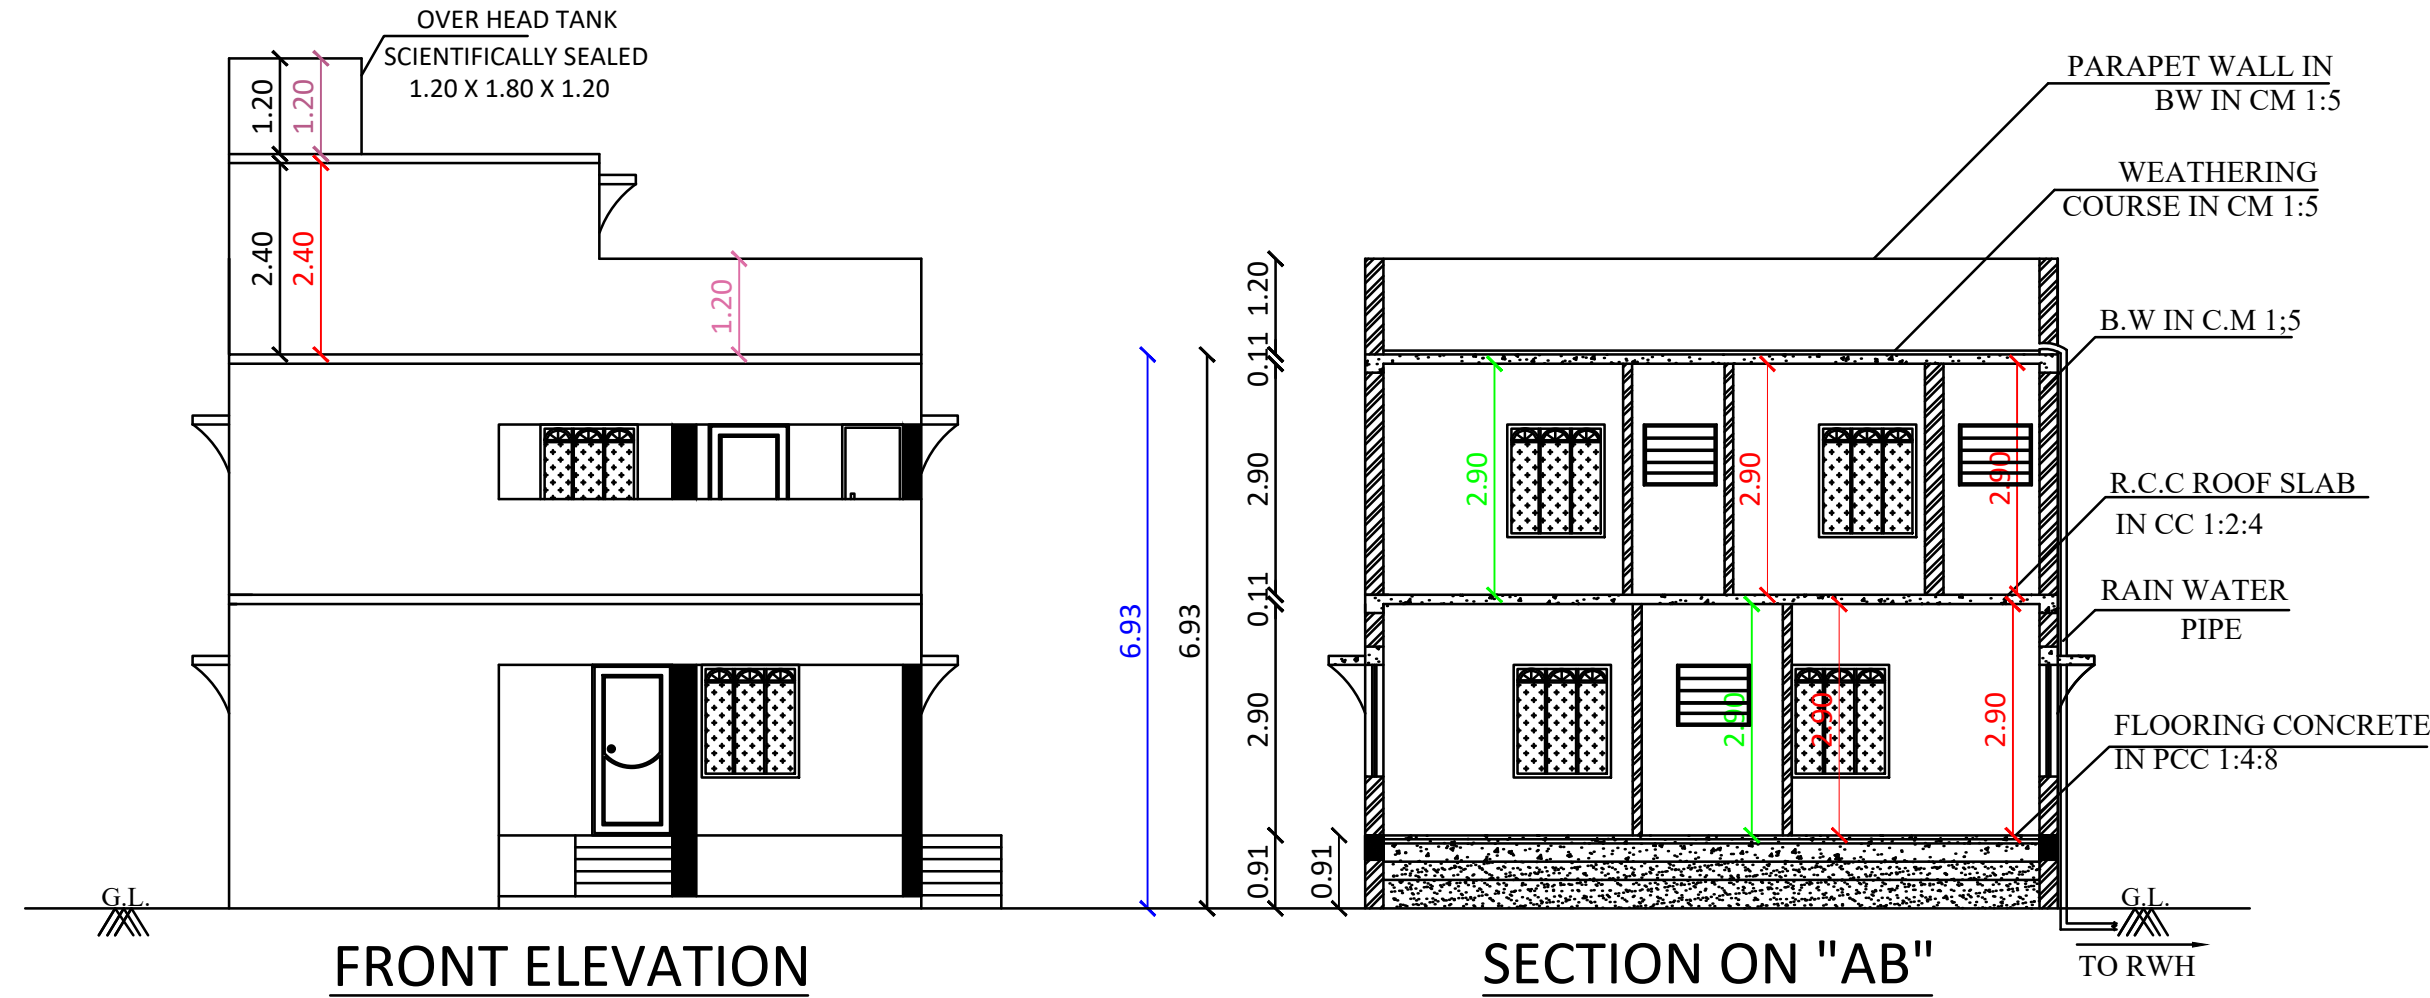

Layout Approved By Thaliyur
Executive Officer
Approved No:548/1992

Plot Approved in Regularization
Scheme Vide in
Lr.No:418/2025/A2
Dated:25.08.2025

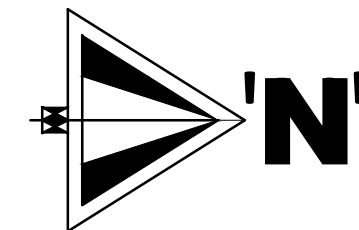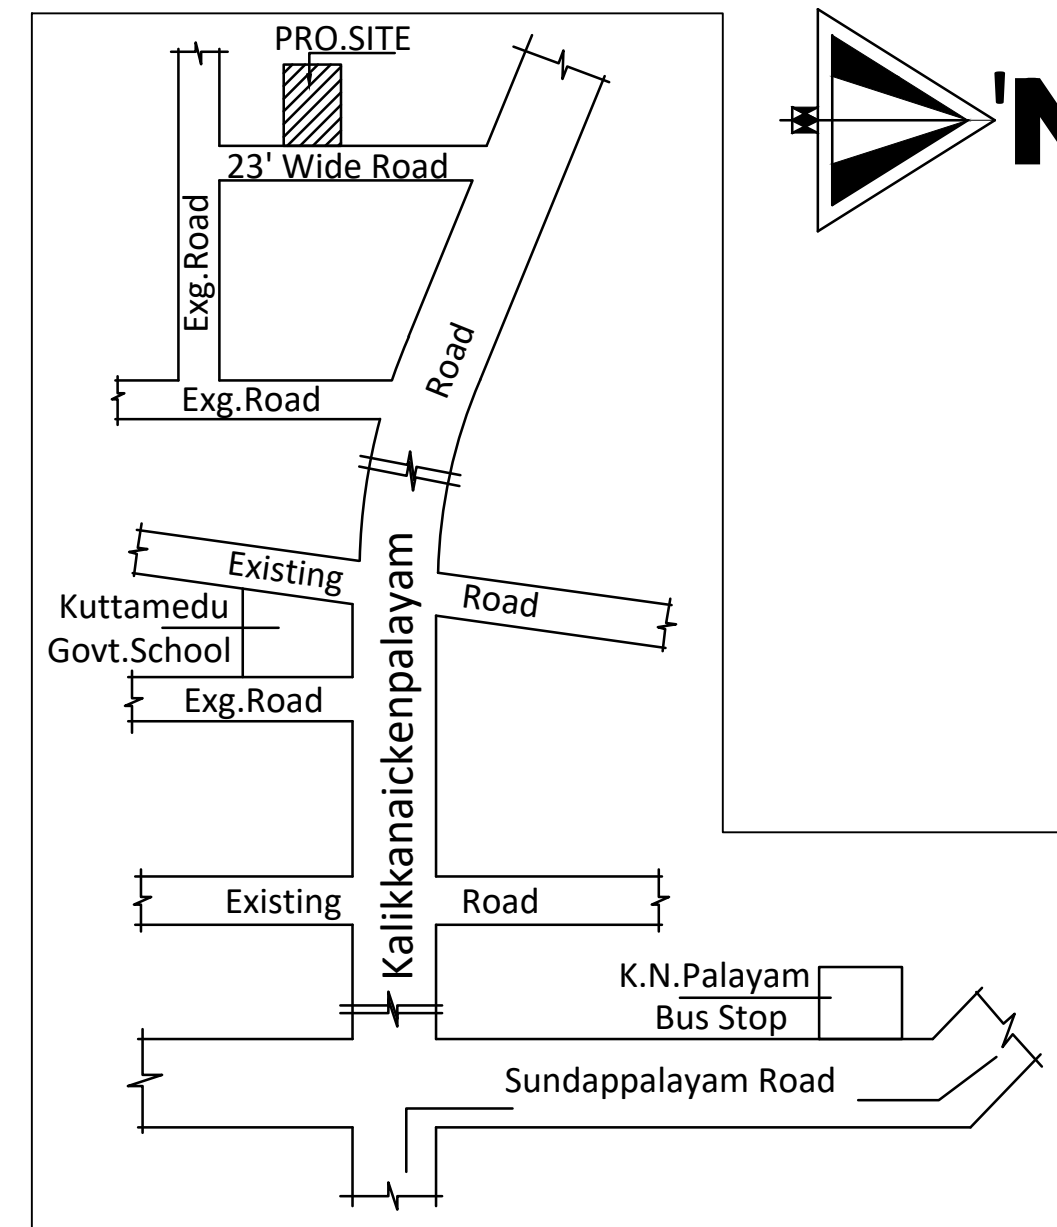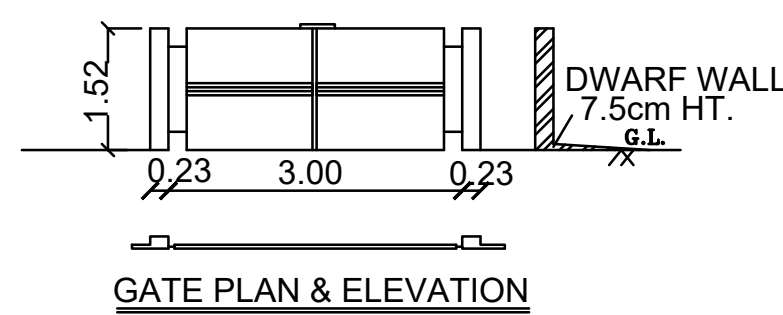

PLAN SHOWING THE PROPOSED CONSTRUCTION
OF A RESIDENTIAL BUILDING AT SITE NO:166, IN
SURVEY NO:111/14A1B AS PER PATTA NO:4932,
C.P.C AVENUE -2, KALIKKANAICKENPALAYAM
VILLAGE, PERUR TALUK, COIMBATORE DISTRICT,
THALIYUR TOWN PANCHAYAT LIMIT.

OWNER NAME:Mr.J.JEYAKUMAR

SCALE: 1:100

JOINERY DETAILS

TYPE	METRIC		DESCRIPTION
	WIDTH	HEIGHT	
MD	1.00	2.13	T.W FRAMED MARINE PLY. PANELLED DOOR.
D1	0.91	2.13	T.W FRAMED MARINE PLY. PANELLED DOOR TO DETAIL.
D2	0.76	2.13	T.W FRAMED MARINE PLY. PANELLED DOOR TO DETAIL.
W	1.22	1.40	T.W FRAMED PANELLED OPENABLE WINDOW WITH 3 EQL SHUTTERS
W1	1.00	1.00	T.W FRAMED PANELLED OPENABLE WINDOW WITH 3 EQL SHUTTERS
OP	0.91	2.13	OPENING
V	0.91	0.76	T.W FRAMED GLAZED SPLIT TYPE VENTILATOR TO DETAIL.

AREA DETAILS	SQMT	SQFT
PLOT AREA (As per Doc.)	162.58	1750.00
PLOT AREA (As per Patta)	163.00	
PRO. G.FLOOR	110.46	1189.00
PRO. F.FLOOR	110.46	1189.00
TOTAL	220.92	2378.00

F.S.I - 1.36

NON-F.S.I AREA

PRO.HEAD ROOM	10.48	113.00
---------------	-------	--------

COLOUR INDEX

PROPOSED	—	—
ROAD	—	—
BOUNDARY	—	—

NOTE:-

- NO. OF FLOOR : G + 1
- NO. OF DWELLING : 3













OWNER:-

J. Jaya Kumar

REGISTERED ENGINEER:-

J. Mary Roslen
J.MARY ROSLEN, D.C.,D.C.E.,
No:10, AMBAL NAGAR,
SIKKARAYAPURAM,
COIMBATORE-641 109

Ref.no-1 [12.09.2025]

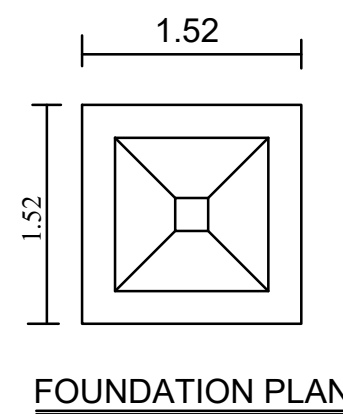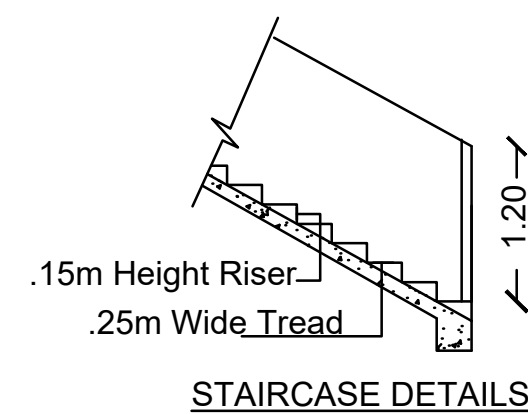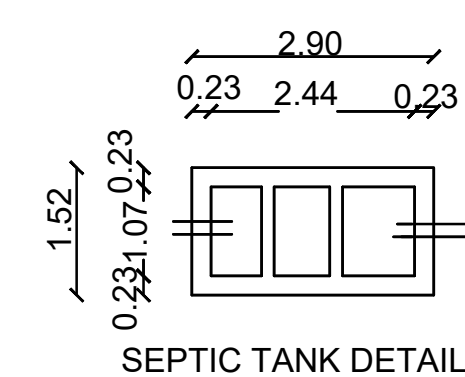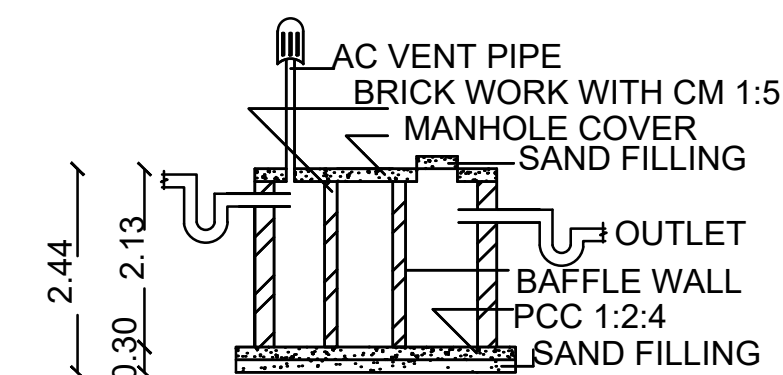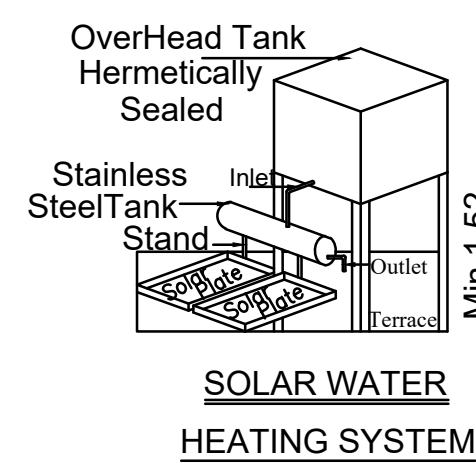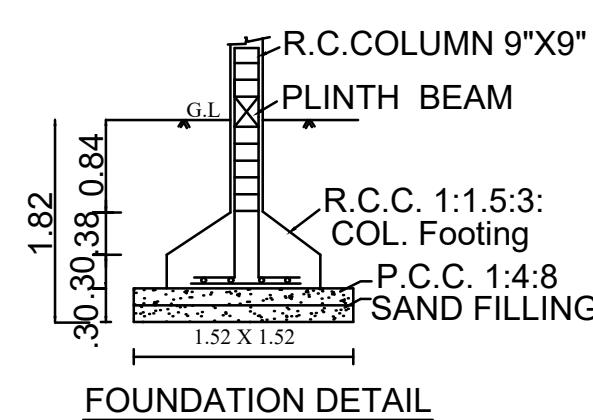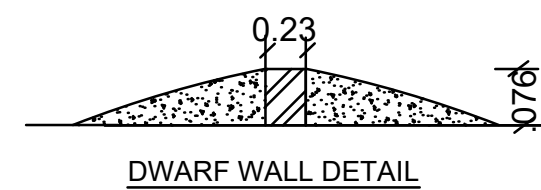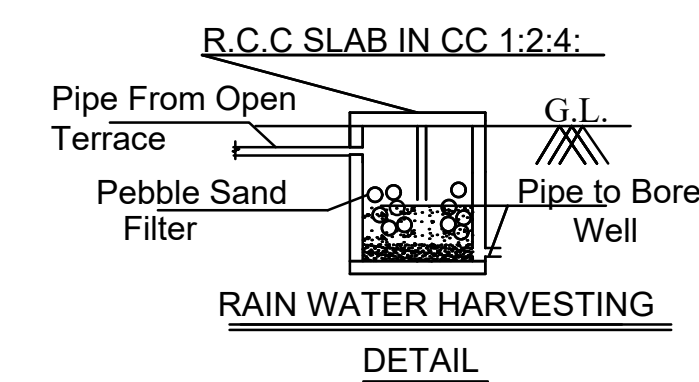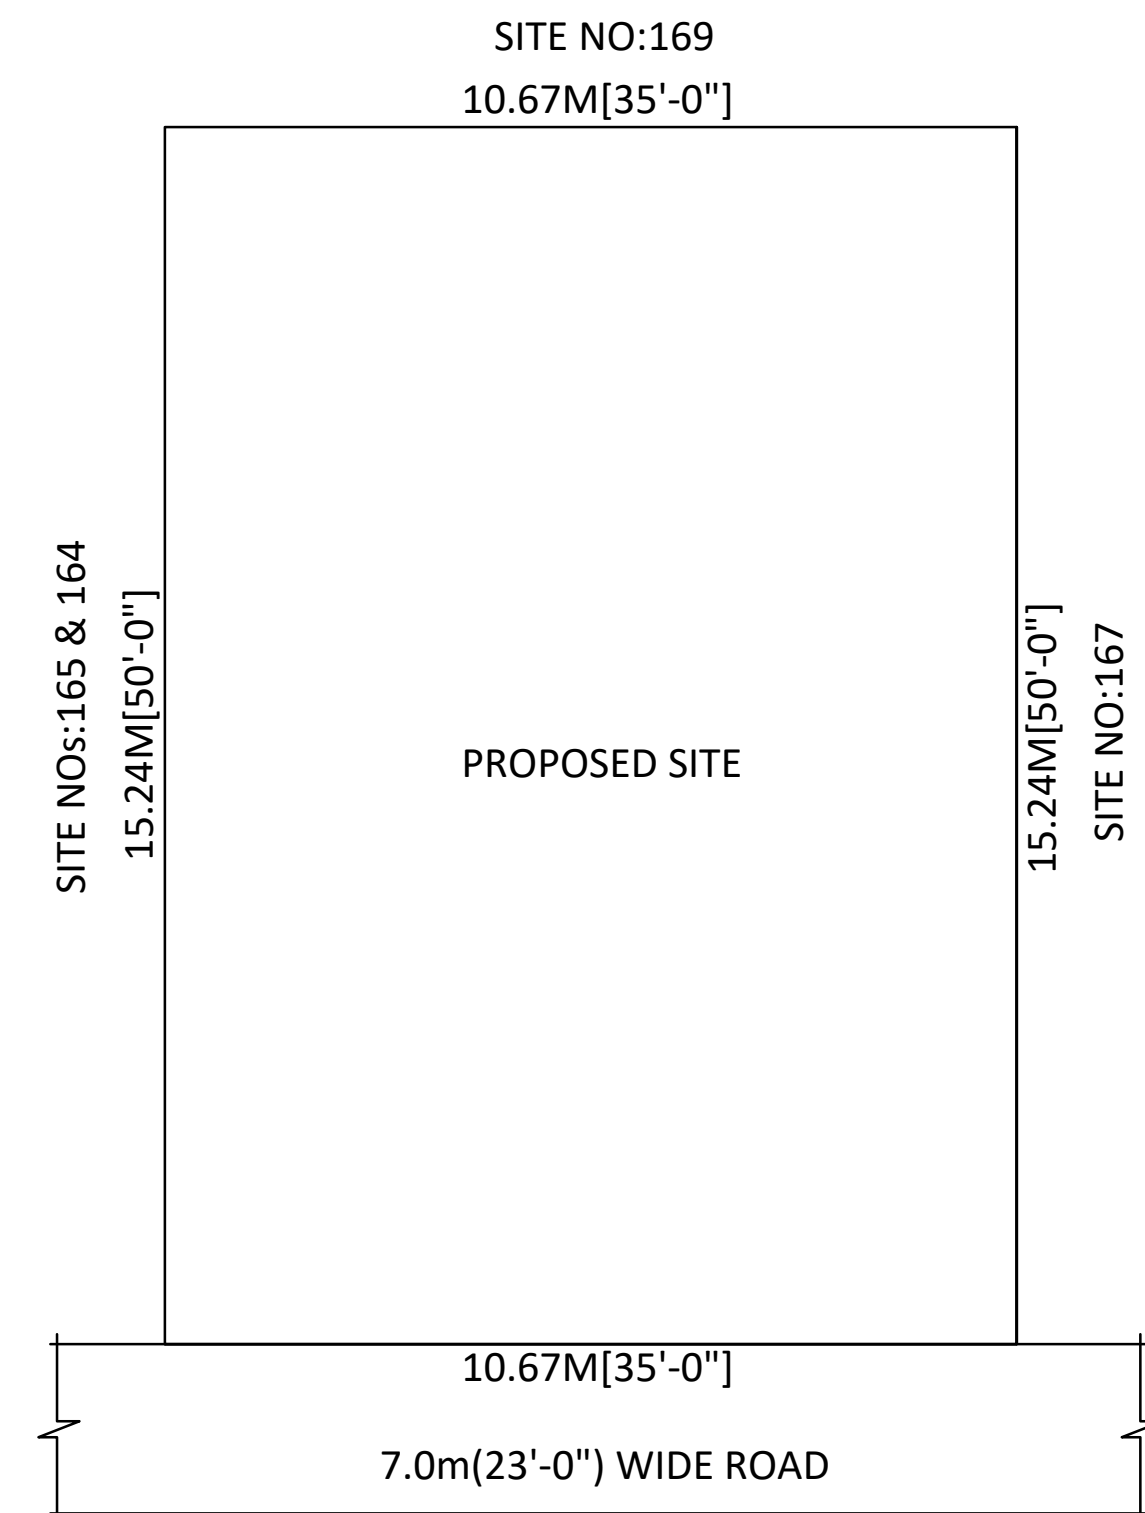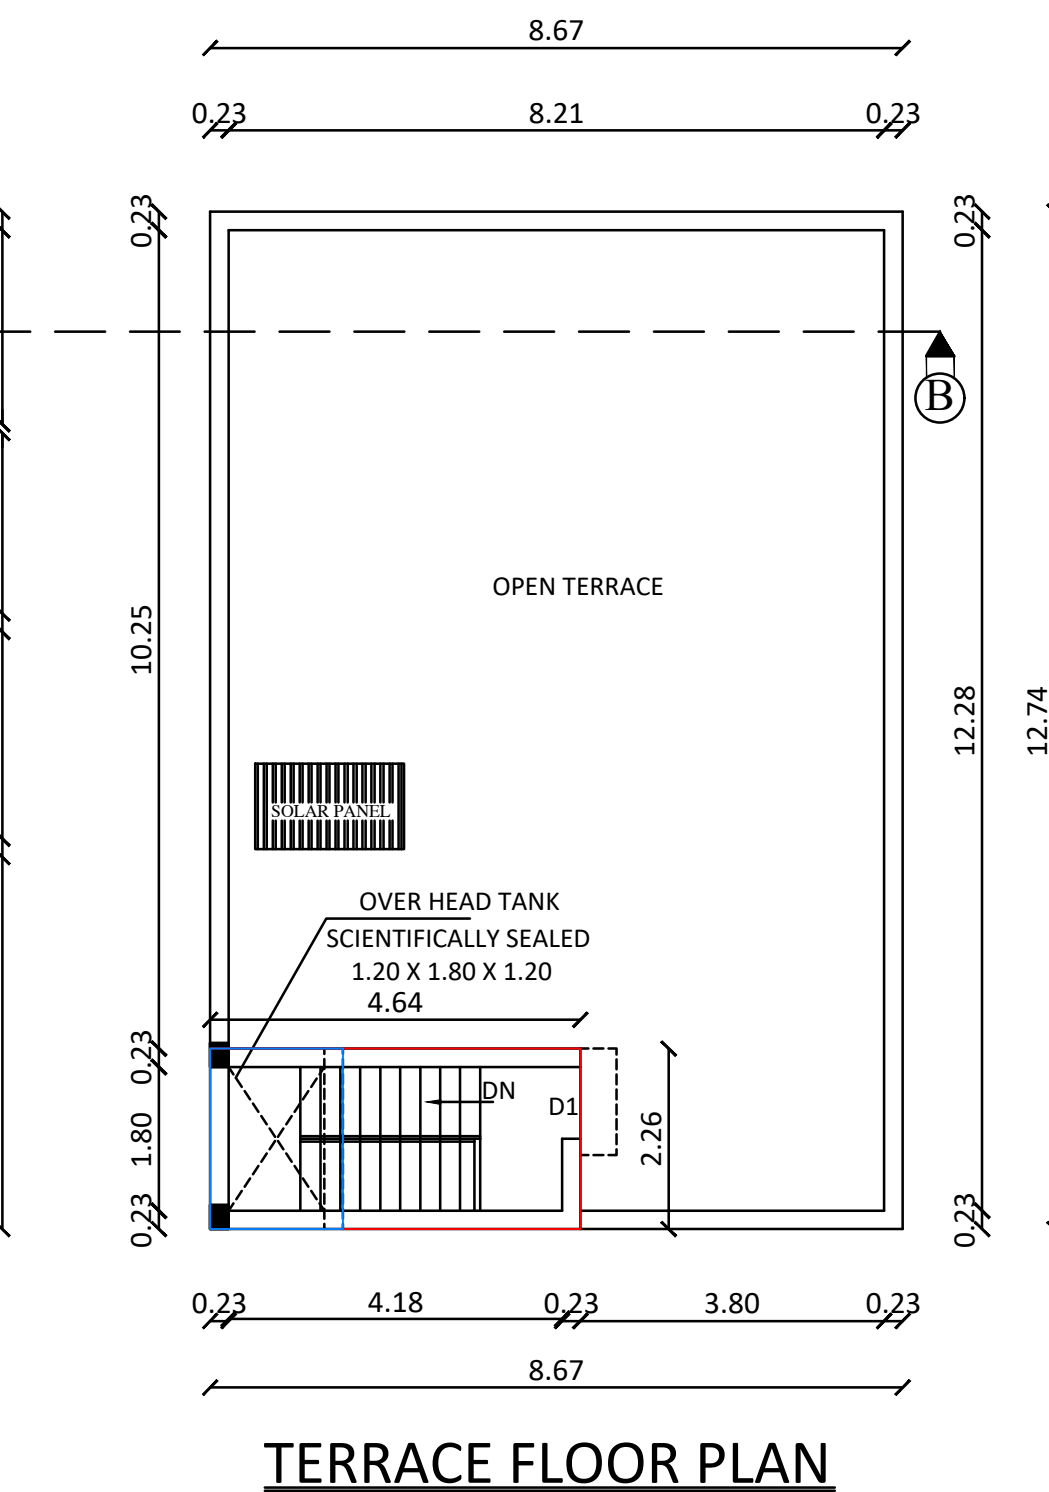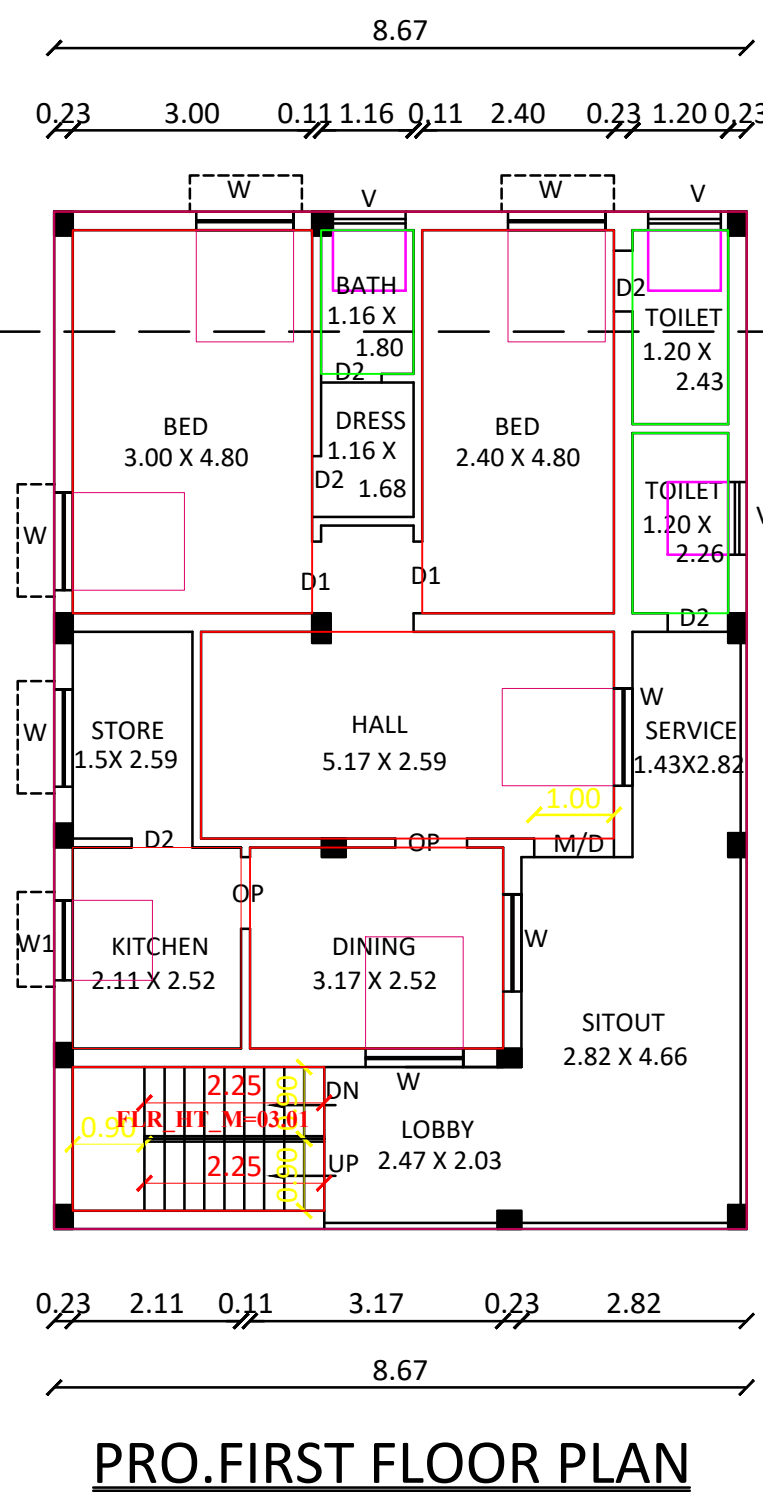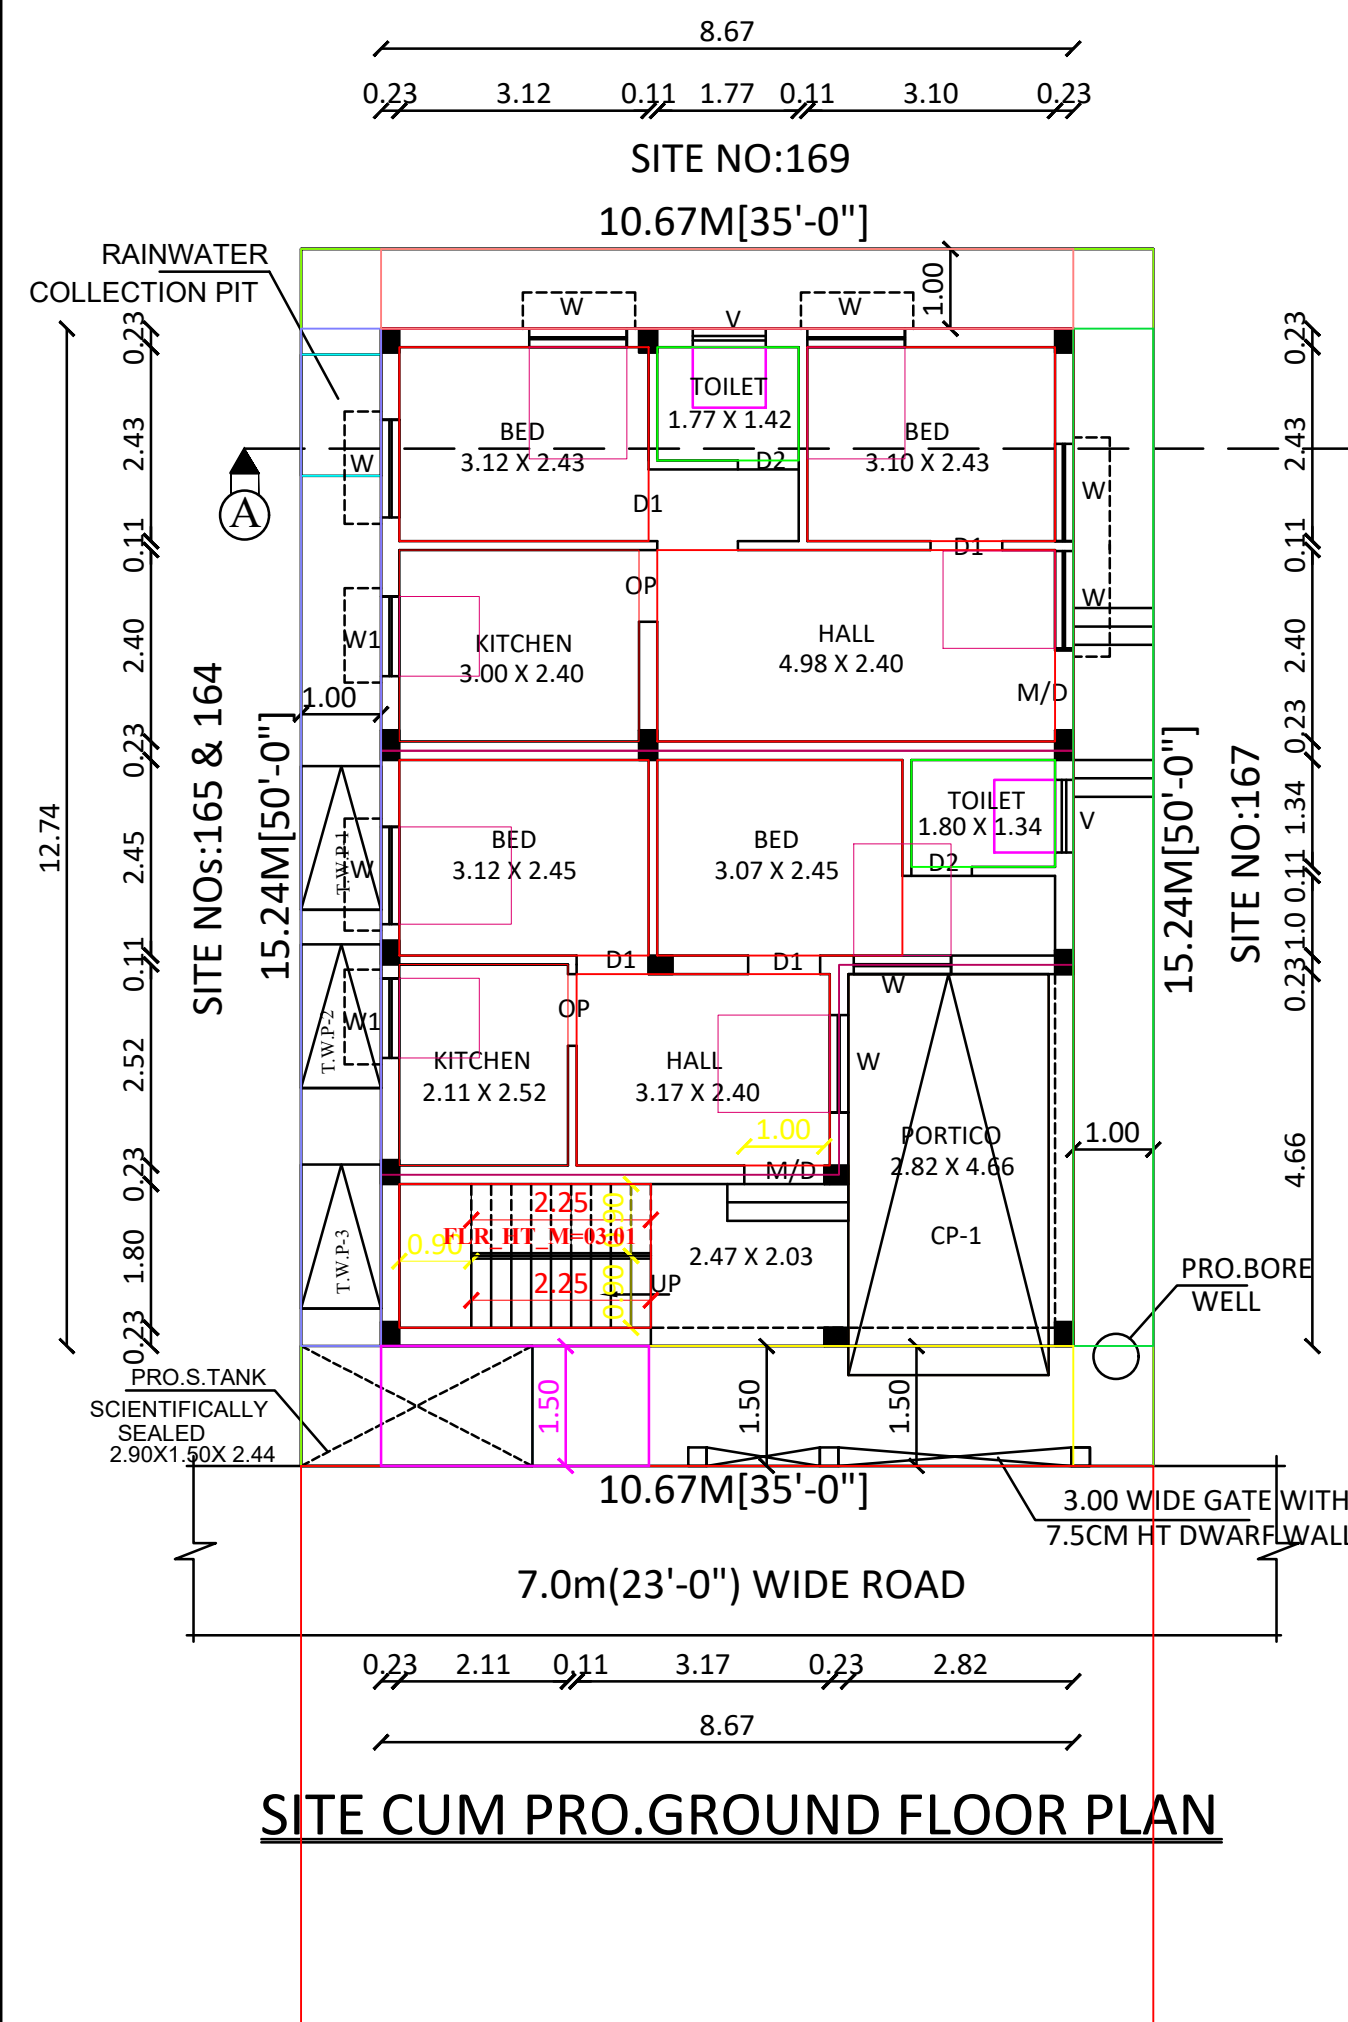

OFFICE USE



Eight ways to know a piece of land before you pay for it.

This report covers one part of the picture. These cover the rest, drawn from the same government records, for any property in Tamil Nadu.

LandLens One

Ask anything about a property and get an answer grounded in live government records, with the sources shown.

[/landlens/one](#)



Verify My Land

Every record check run on one property and returned as a single report.

[/landlens/verify-my-land](#)



Legal Opinion

An advocate's written opinion on the title, built on the records we pull for it.

[/landlens](#)



One Map

Every layer on one map: the parcel, its boundary, zoning, water bodies and what sits around it.

[/landlens/one/map](#)



PriceMap

What land actually changed hands for around this plot, taken from the registered deeds.

[/landlens/pricemap](#)



Build Scope

What you are allowed to build here: floor space, height, coverage and setbacks.

[/landlens/build-scope](#)



Property Tracker

Watch a property and hear about it when something new is registered against it.

[/landlens/property-tracker](#)



Deal Room

Run the transaction in one place: documents, stamping, signatures and the parties.

[/landlens/deal-room](#)



Twenty-four checks you can run yourself, at no cost.

Records and verification

The registers themselves, read for you.

Encumbrance Certificate

Patta and Chitta

Field Measurement Sketch

EC Analyzer

Bank charge check

Court case search

Seller background check

Approval check by survey

Value and duty

What it is worth and what it costs to register.

Guideline value by street

Guideline value by survey

Stamp duty and registration fees

Capital gains

Floor space index

Area unit converter

Zoning and land use

What the plan says can happen on this land.

Land use zone finder

CMDA land use check

Coastal regulation zone

Master plan check

Water bodies finder

Airport height clearance

Registers and directories

Who holds it, and which office keeps the record.

Find your registering office

Temple property check

Waqf property check

RERA register



Every free tool
/tools



Services we run
for you
/services



The LandLens
suite
/landlens/one



Every claim in this document traces back to a government record.

Legal opinions, due diligence and title verification

Building plan, layout and sub-division approvals

Completion and occupancy certificates, regularisation

Escrow, negotiation and NRI property management

Land survey, soil testing, architecture and construction

Verified RealEstate
3/350/2 Mettukuppam,
OMR Thoraipakkam,
Chennai 600 097, India
hello@verified.realestate
+91 9996 12 9996

Prepared from the registers named on the page each finding sits on. Where a register could not be read, this document says so in its place rather than leaving the gap to be read as a clean result.

