PP APPROVAL RECORD

Planning Permission

Dindigul district, Tamil Nadu

APPROVAL TYPE
Building Plan

ISSUING AUTHORITY
DTCP


The approval as the planning authority issued it, reproduced in full behind this page.

An approval speaks to what was sanctioned, not to what was built. Completion is a separate record.


Verified RealEstate™
3/350/2 Mettukuppam,
OMR Thoraipakkam,
Chennai 600 097, India

hello@verified.realestate
+91 9996 12 9996
verified.realestate

BUILDING PLAN
(SCALE 1:100)

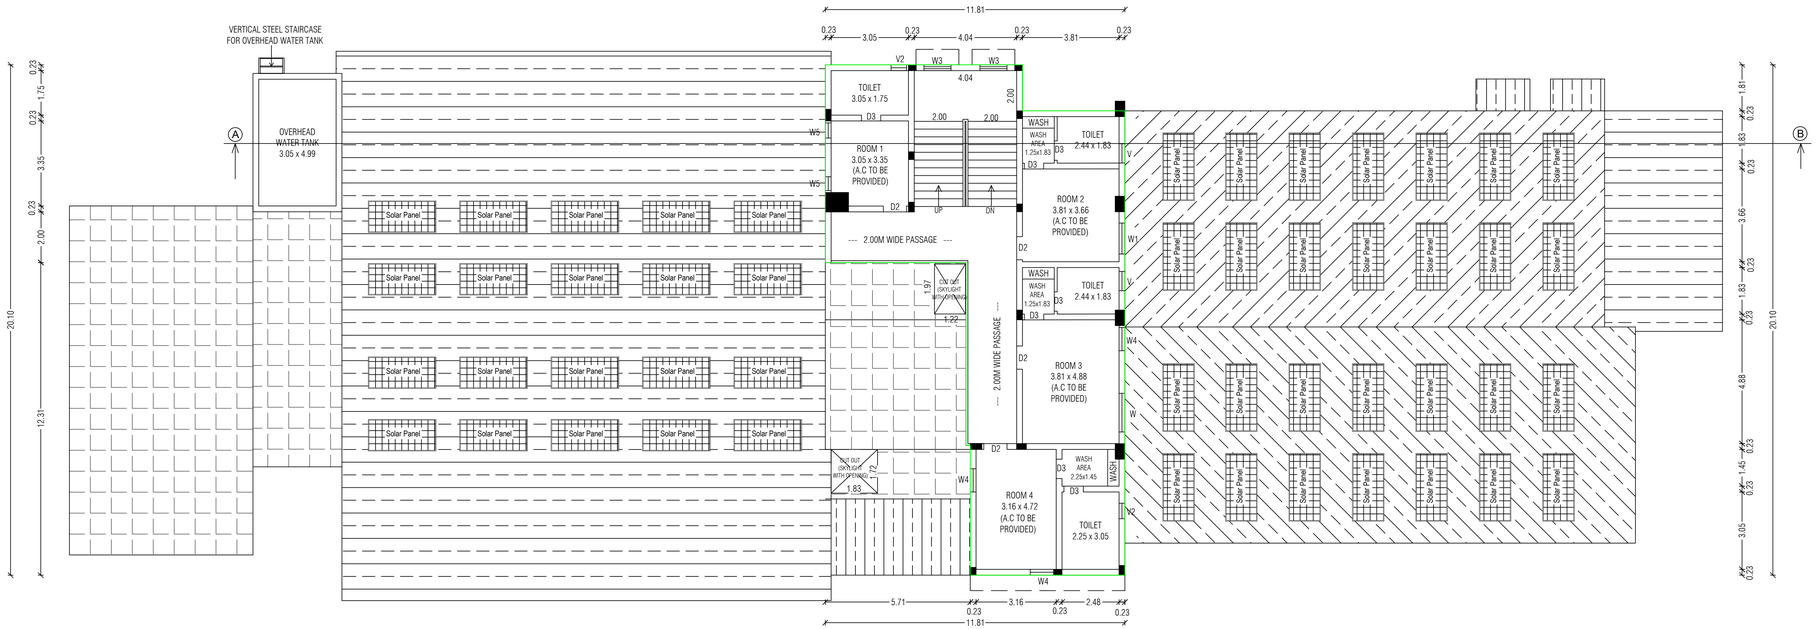

FIRST FLOOR PLAN

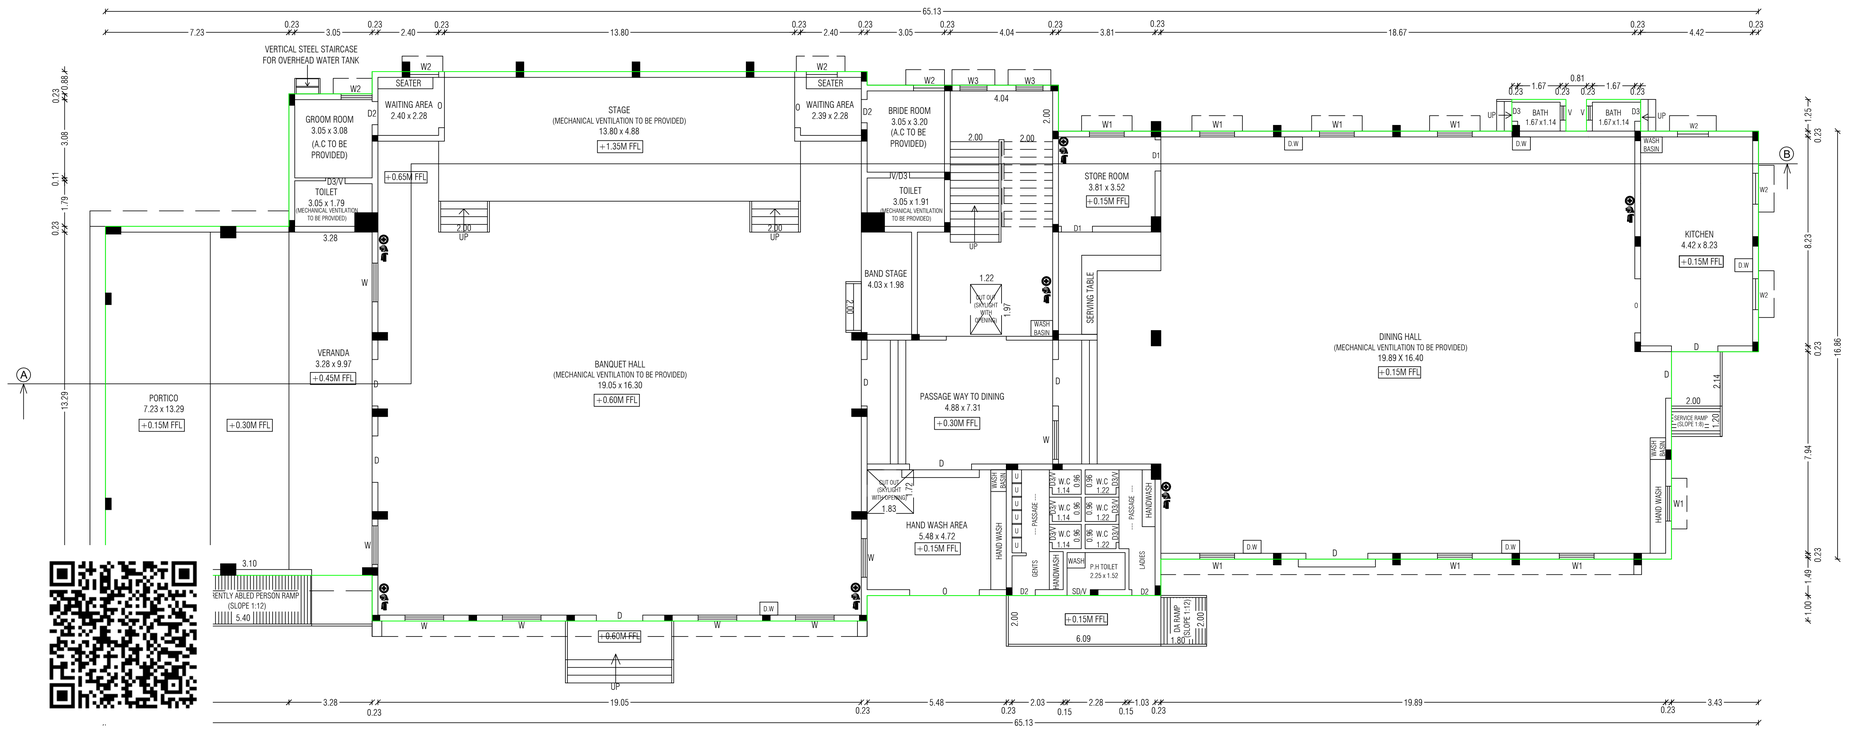

GROUND FLOOR PLAN

EE	EMERGENCY EXIT
	FIRE EXTINGUISHER
	FIRST - AID BOX
	FIRE HOSE REEL

E-SIGNED

DISTRICT DIRECTOR,
DISTRICT TOWN AND COUNTRY PLANNING,
DINDIGUL DISTRICT.

REVISED BUILDING PLAN SHOWING THE PROPOSED CONSTRUCTION OF MARRIAGE HALL BUILDING IN S.F.NO: 256/8 AT THOTTANUTHU VILLAGE & PANCHAYAT, DINDIGUL EAST TALUK, DINDIGUL DISTRICT.

All Dimensions Are In Meters
SCALE : [1:100]

W
S — N
E

EXISTING APPROVAL DETAILS:

Online Application No : SWP/BPA/740227/2025 (Date : 20.01.2026)
Site Boundary Shown as "A to K" And Numbered as
BUILDING PERMISSION :
Numbered As: SWP/DTCP/ Dindigul / BUILDING PERMISSION NO : 02/2026 (Date : 20.01.2026)
PLANNING PERMISSION :
Numbered As: SWP/DTCP/ Dindigul / PLANNING PERMISSION NO : 06/2026 (Date : 20.01.2026)

REVISED APPROVAL DETAILS:

Online Application No : SWP/BPA/890792/2026 (Date : 04.07.2026)
Site Boundary Shown as "A to K" And Numbered as
BUILDING PERMISSION :
Numbered As: SWP/DTCP/ Dindigul / BUILDING PERMISSION NO : 39/2026
PLANNING PERMISSION :
Numbered As: SWP/DTCP/ Dindigul / PLANNING PERMISSION NO : 39/2026

SITE AREA DETAILS :-

SURVEY.NO	AS PER DOCUMENT	AS PER PATTA
256 / 8	4700.00 SQ.MT	4700.00 SQ.MT

PROPOSED BUILDING AREA DETAILS :-

DESCRIPTION	FSI sq.mt	NON - FSI sq.mt	TOTAL sq.mt
GROUND FLOOR AREA	1177.00	---	1177.00
FIRST FLOOR AREA	160.90	---	160.90
TERRACE FLOOR AREA	---	35.01	35.01
TOTAL	1337.90	35.01	1372.91

$$FSI = \frac{\text{Total FSI Area}}{\text{Total Site Area}} = \frac{1337.90}{4700.00} = 0.28 < 2.00$$

NUMBER OF SEATING ARRANGEMENTS - 200

TOTAL BUILDING HEIGHT : 7.57 m

SANITATION REQUIREMENTS

MALE - 100 Nos / STAFF - 10Nos | FEMALE - 100 Nos / STAFF - 10 Nos

DESCRIPTION		REQUIRED	PROVIDED
WATER CLOSET	MALE (1 FOR 100 PERSONS UPTO 400 PERSONS)	1	2
	MALE STAFF (1 FOR 15 PERSONS)	1	1
	FEMALE (2 PER 100 PERSONS UPTO 200 PERSONS)	2	2
	FEMALE STAFF (1 FOR 1 TO 12 PERSONS)	1	1
	PH TOILET	1	1
URINAL	MALE (1 PER 50 PERSONS)	2	4
	STAFF (1 FOR 7 TO 20 PERSONS)	1	2
WASH BASIN	MALE (1 FOR EVERY 200 PERSONS)	1	1
	MALE STAFF (1 FOR 1 TO 15 PERSONS)	1	1
	FEMALE (1 FOR EVERY 200 PERSONS)	1	1
	FEMALE STAFF (1 FOR 1 TO 12 PERSONS)	1	1
DRINKING WATER	(1 PER 100 PERSONS)	4	6
BATH	1 PER 200 PERSONS	2	2

SPECIFICATION:-

. FOUNDATION	:	R.C.C COLUMN FOOTING 1:2:4 MIX OVER A BED OF C.C 1:5:10 MIX.
. BASEMENT	:	R.C.C COLUMN FOOTING 1:2:4 MIX, BRICK WORK IN C:M 1:6 MIX.
. SUPERSTRUCTURE	:	BRICK WORK IN C:M 1:6 MIX.
. ROOFING	:	R.C.C ROOF SLAB 1:2:4 MIX, 0.15M THICK AND GALVALUME SHEET
. FLOORING	:	C.C FLOORING 1:5:10 MIX 0.33 THICK AND TOP FINISHED WITH C:M 1:3 MIX, 0.23 TK.
. PLASTERING	:	CEMENT PLASTERING 1:5 MIX, 0.15 TK.
. USE	:	MARRIAGE HALL BUILDING.

JOINERIES — METER

D -	DOOR	1.83 X 2.44
D1 -	DOOR	1.22 X 2.44
D2 -	DOOR	0.91 X 2.44
D3 -	DOOR	0.76 X 2.13
S.D-	SLIDING DOOR	1.00 X 2.13
O -	OPEN	2.13 X 2.44
O1 -	OPEN	0.91 X 2.44
W -	WINDOW	1.52 X 1.83
W1-	WINDOW	1.37 X 1.68
W2-	WINDOW	1.22 X 1.53
W3-	WINDOW	1.07 X 1.53
W4-	WINDOW	0.91 X 1.53
W5-	WINDOW	0.60 X 1.53
V -	VENTILATOR	0.76 X 0.61

NOTE :-

1. L.P. GAS WILL BE USED FOR KITCHEN
2. BORE WELL WITH MOTOR, WATER TANK AND CORPORATION WATER SUPPLY WILL BE PROVIDED.
3. SULLAGE WASTE FROM TOILET WILL BE CONNECTED EXISTING
4. RAIN WATER PERCOLATION PITS OF 4NOS. PROVIDED @ 1/30 SQM OF PLINTH AREA @ 3M C/C
5. RAIN WATER PERCOLATION BED 1.0M WIDE WILL BE PROVIDED AROUND THE BUILDING AS PER GO (MS) NO. 138 DATED
6. PERCOLATION BED OUT SIDE ALONG PLINTH TO BE PROVIDED
7. OUTER PAVEMENTS SLOPING TO WARDS RAIN WATER PERCOLATION PIT ALONG PLINTH
8. RAIN WATER TAKEN TO THE BORE WELL THROUGH 150MM DIA PIPES.
9. RAIN WATER COLLECTED FROM OPEN TERRACE SHALL BE COLLECTED THROUGH PIPES AND LED INTO A FILTER PIT (SIZE 60x60x60CM) WITH APPROPRIATE FILTER MATERIAL AND THEN LED INTO COLLECTION TANK.
10. SOLAR WATER HEATER LINE ARRANGEMENTS WILL BE PROVIDED.
11. ALL DIMENSIONS ARE IN METRE.
12. KITCHEN EXHAUST FAN TO BE PROVIDED.
13. FA - FIRE ALARAM PROVIDED
14. FE - FIRE SAFETY MEASURES PROVIDED.
15. SB - SAND BUCKET PROVIDED.
16. MECHANICAL VENTILATION TO BE PROPOSED.

STRUCTURAL ENGINEER

Er.S.SURENDAR, B.E.,M.E.
62,Alagumpatti, Balasingham,
Dindigul-624005.
Mob : 6379643207
REGISTERED STRUCTURAL ENGINEER
DINDIGUL LPA REG.No : SE 01/2021(G-I)

CONSTRUCTION ENGINEER


Dr.J.JEYAWILSON, B.E.,M.E.,
Registered Construction Engineer
DLPA Reg. No: CE 02/2025 (DTCP)
HI-TECH PROMOTERS, HANIN TOWERS
Annamalaiyar School Road,
Near Koundama, Nagal Nagar,
Dindigul - 624 003. Cell : 90779 12660

REGISTERED ENGINEER


Er. P. ANBAZHAGAN, B.E.,M.C.E.,F.I.V.,
Chartered Engineer and Valuer,
DLPA-RE 01/2025(GR-I) & RSE04/2024(GR-II),
16,VIVEKANANDA NAGAR, DINDIGUL.
CELL : 91501 69343

APPLICANT


SECTION & ELEVATION
(SCALE 1:100)

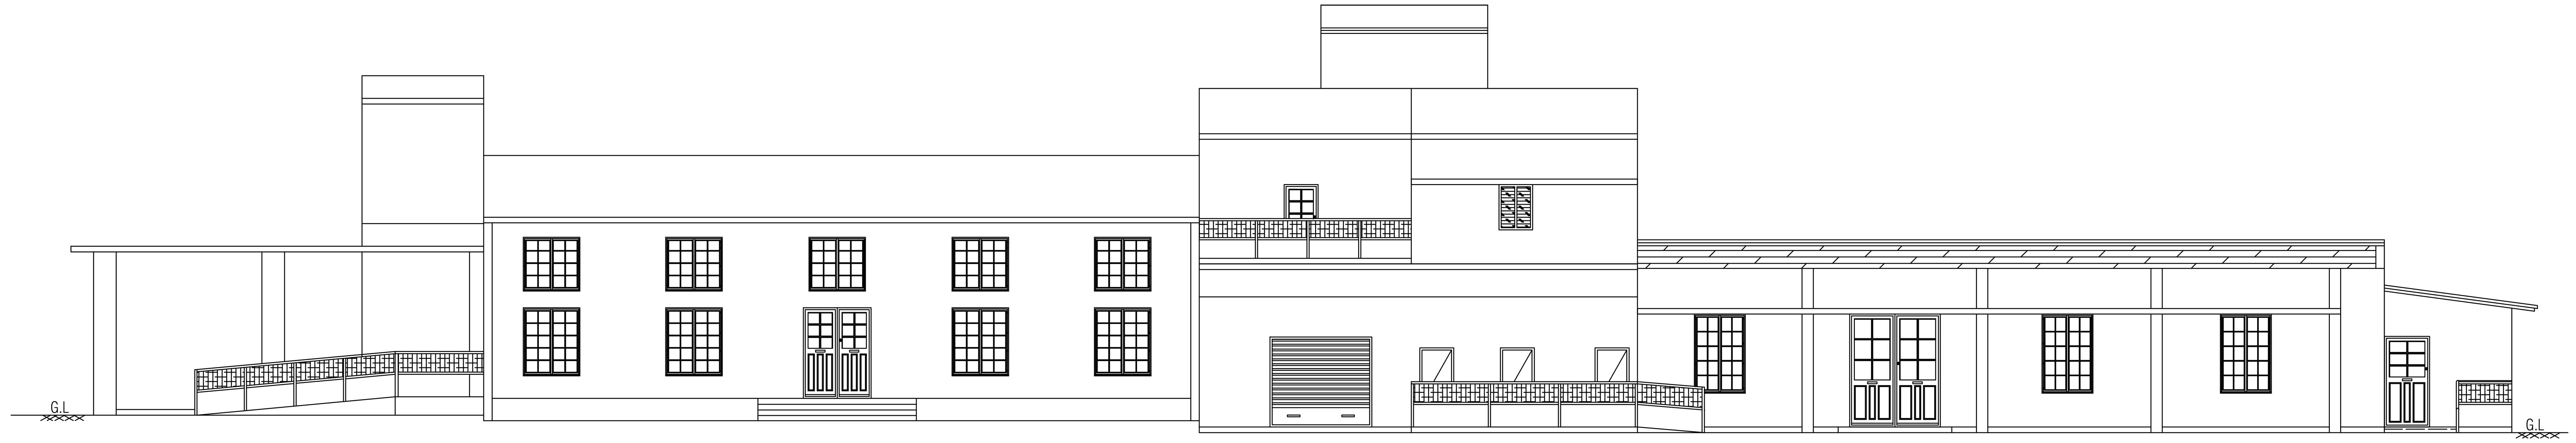


EAST SIDE ELEVATION

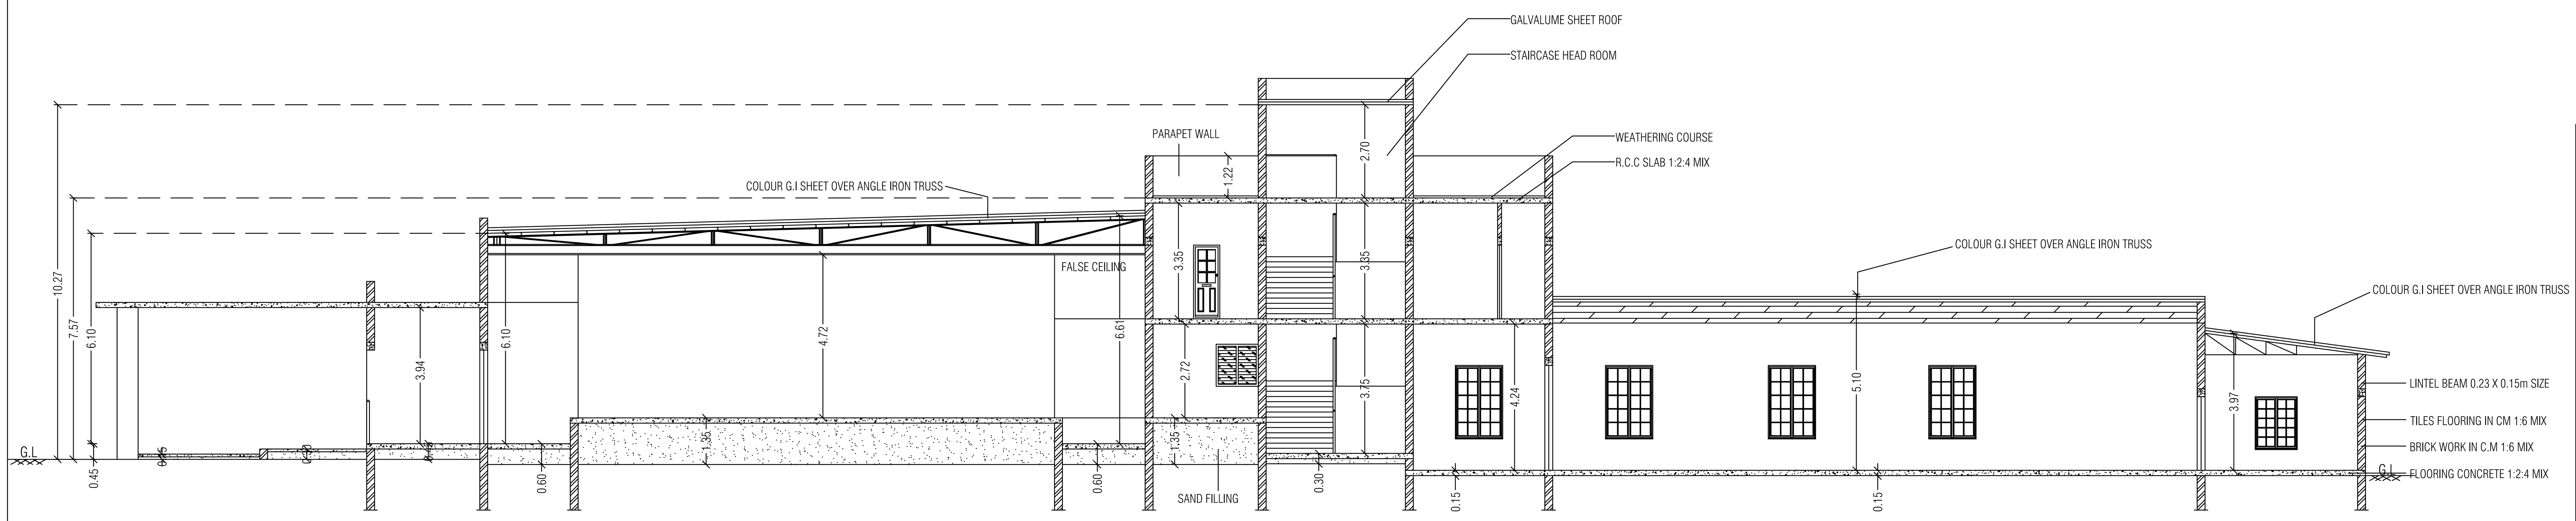


SECTION - (A-B)

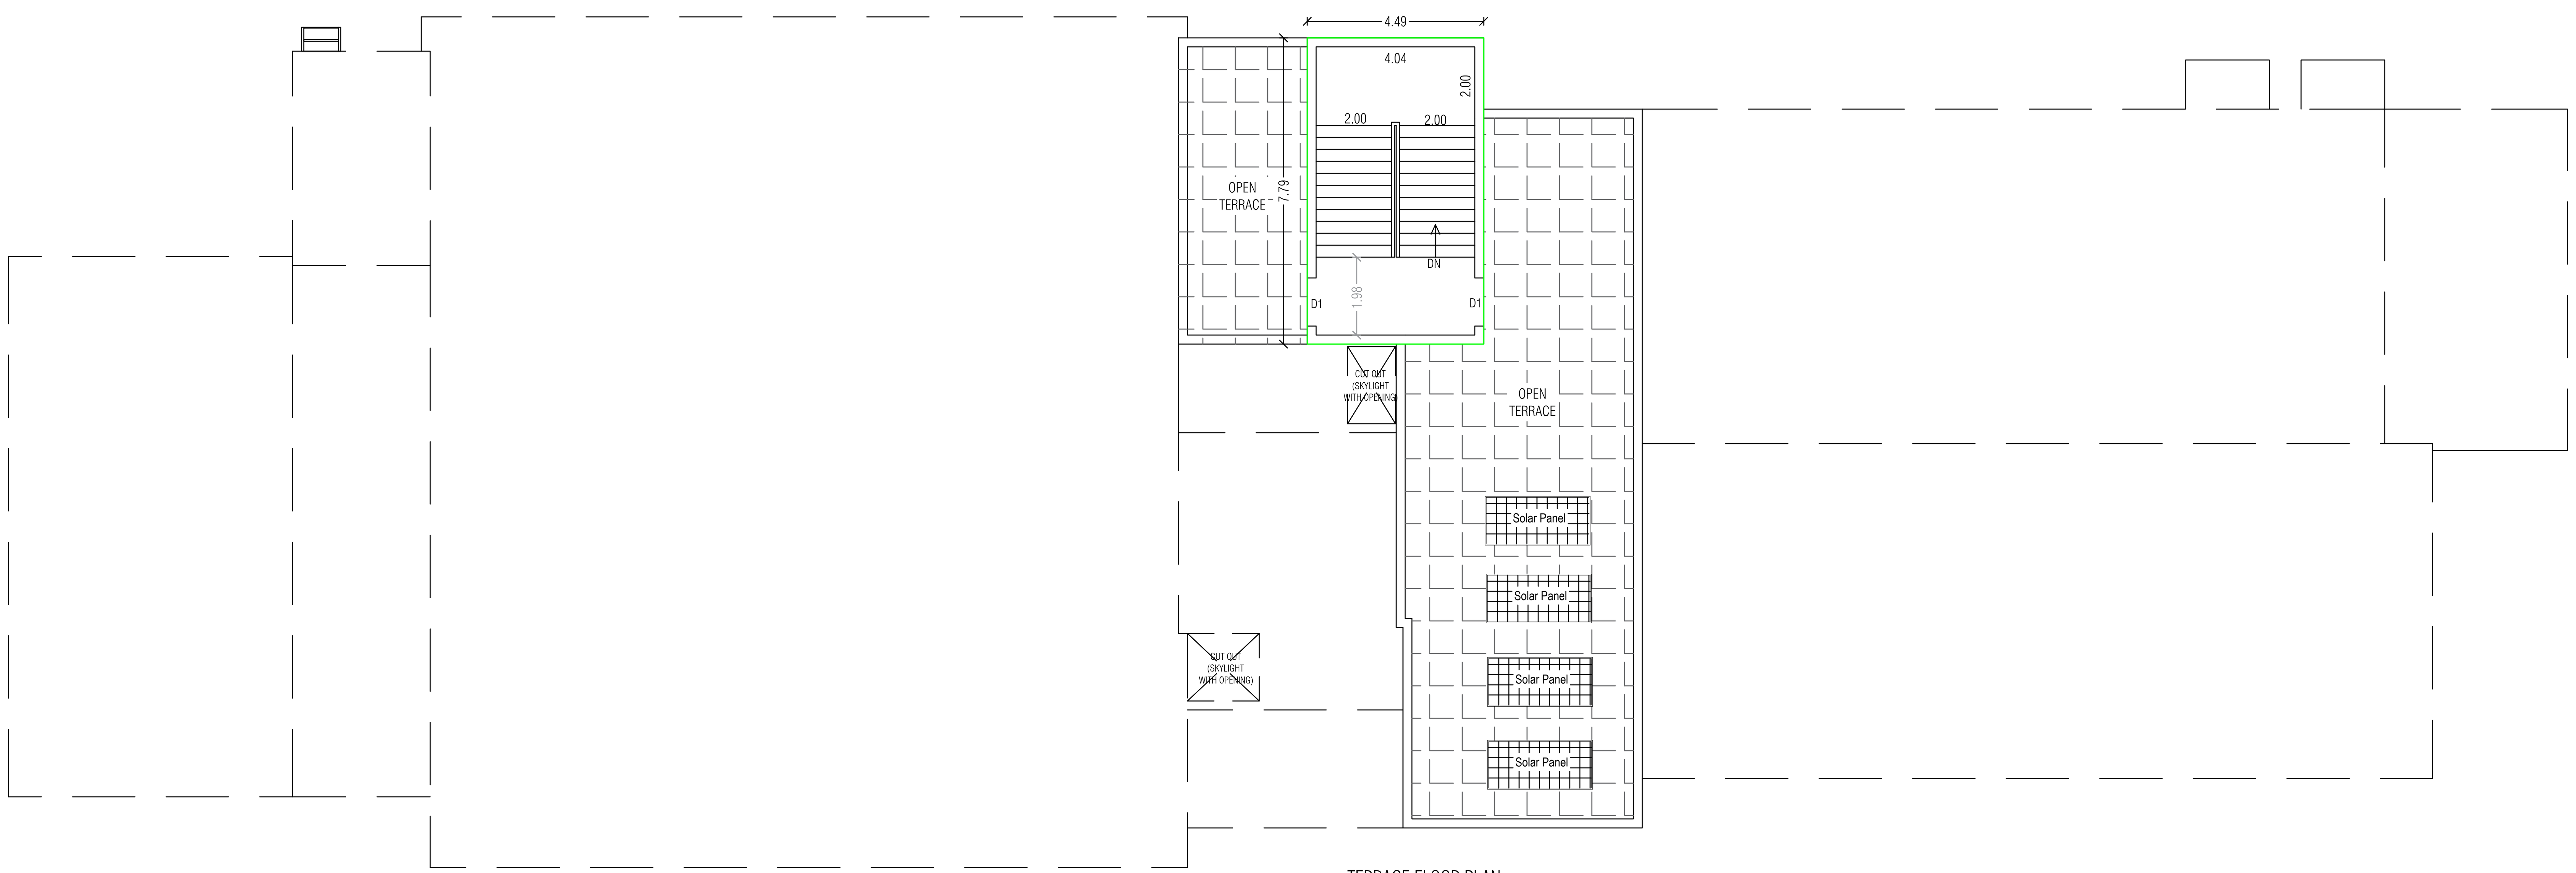


TERRACE FLOOR PLAN

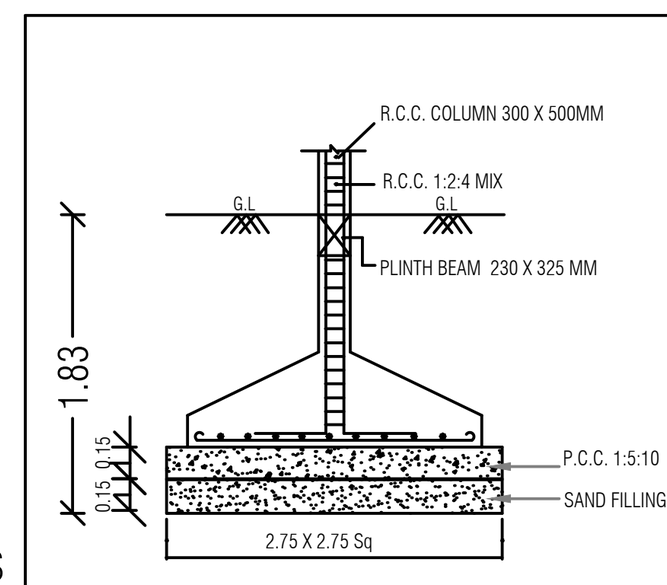


FOUNDATION DETAIL

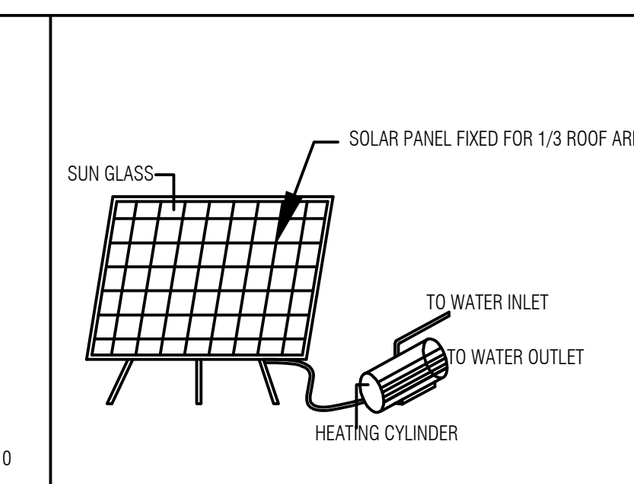


SOLAR PANEL PLAN

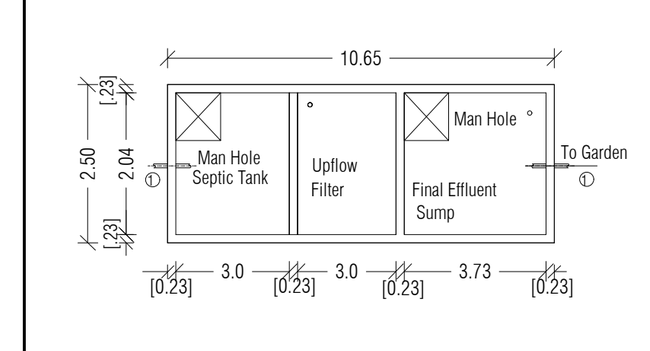


SEPTIC TANK WITH UP-FLOW DETAILS

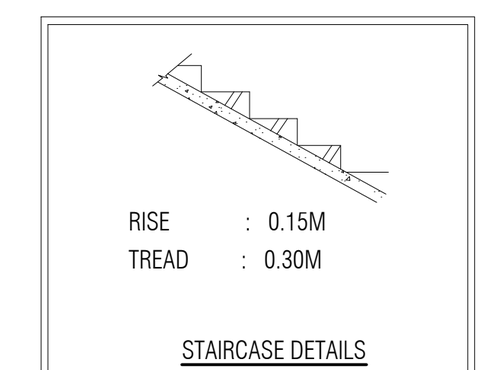


STAIRCASE DETAILS

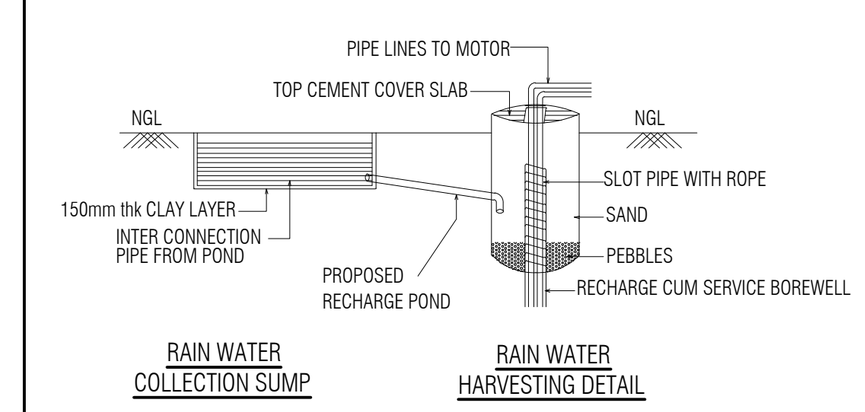


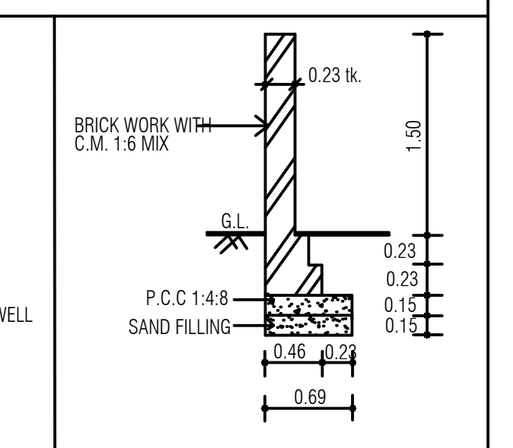


SECTION OF COMPOUND WALL

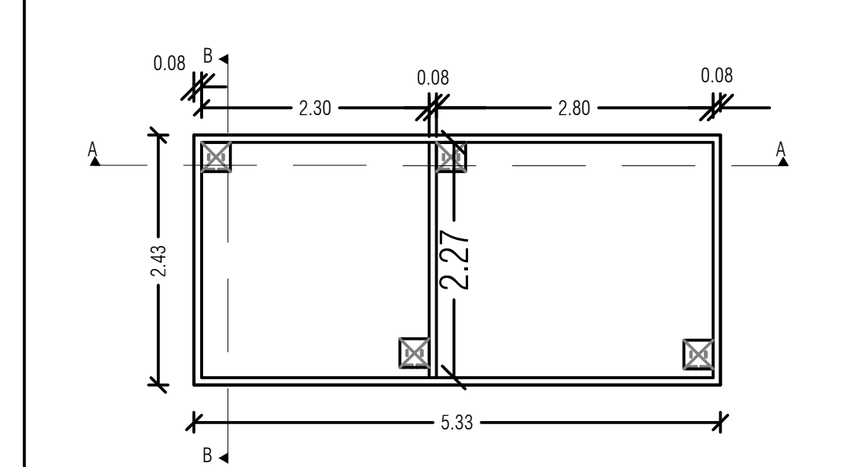


UG SUMP PLAN

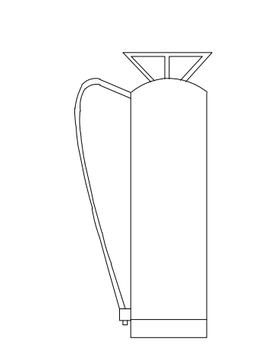


FIRE EXTINGUSHIER (N.T.S)

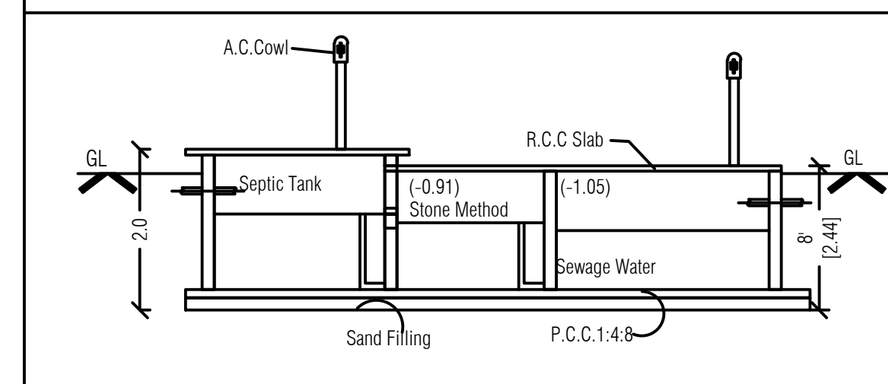

SECTION 1-1

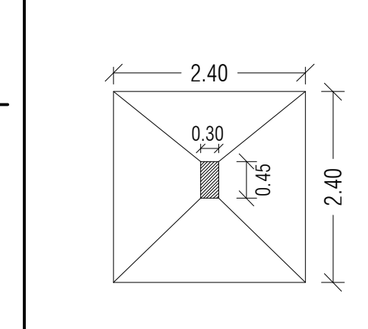

PLAN OF COLUMN FOUNDATION

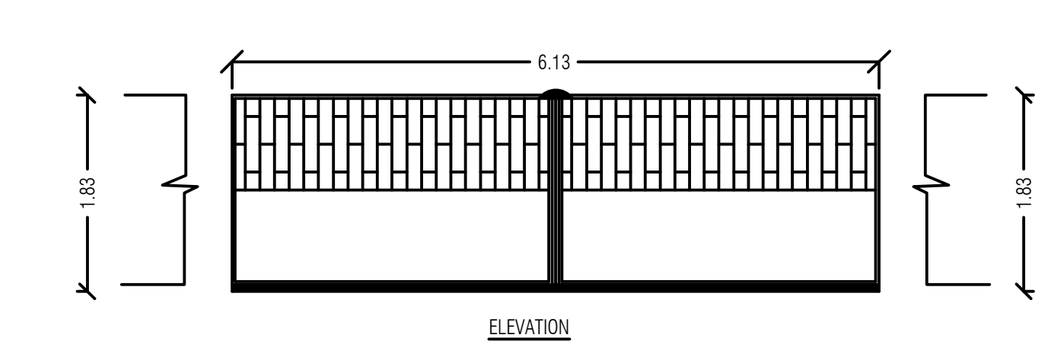

COMPOUND WALL

EE	EMERGENCY EXIT
	FIRE EXTINGUISHER
	FIRST - AID BOX
	FIRE HOSE REEL

E-SIGNED

DISTRICT DIRECTOR,
DISTRICT TOWN AND COUNTRY PLANNING,
DINDIGUL DISTRICT.

SHEET No : 2/3

REVISED BUILDING PLAN SHOWING THE PROPOSED CONSTRUCTION OF MARRIAGE HALL BUILDING IN S.F.NO: 256/8 AT THOTTANUTHU VILLAGE & PANCHAYAT, DINDIGUL EAST TALUK, DINDIGUL DISTRICT.

All Dimensions Are In Meters
SCALE : [1:100]

W / S - N / E

EXISTING APPROVAL DETAILS:

Online Application No : SWP/BPA/740227/2025 (Date : 20.01.2026)
Site Boundary Shown as "A to K" And Numbered as
BUILDING PERMISSION :
Numbered As: SWP/DTCP/ Dindigul / BUILDING PERMISSION NO : 02/2026 (Date : 20.01.2026)
PLANNING PERMISSION :
Numbered As: SWP/DTCP/ Dindigul / PLANNING PERMISSION NO : 06/2026 (Date : 20.01.2026)

REVISED APPROVAL DETAILS:

Online Application No : SWP/BPA/890792/2026 (Date : 04.07.2026)
Site Boundary Shown as "A to K" And Numbered as
BUILDING PERMISSION :
Numbered As: SWP/DTCP/ Dindigul / BUILDING PERMISSION NO : 39/2026
PLANNING PERMISSION :
Numbered As: SWP/DTCP/ Dindigul / PLANNING PERMISSION NO : 39/2026

SITE AREA DETAILS :-

SURVEY.NO	AS PER DOCUMENT	AS PER PATTA
256 / 8	4700.00 SQ.MT	4700.00 SQ.MT

PROPOSED BUILDING AREA DETAILS :-

DESCRIPTION	FSI sq.mt	NON - FSI sq.mt	TOTAL sq.mt
GROUND FLOOR AREA	1177.00	---	1177.00
FIRST FLOOR AREA	160.90	---	160.90
TERRACE FLOOR AREA	---	35.01	35.01
TOTAL	1337.90	35.01	1372.91

$$FSI = \frac{\text{Total FSI Area}}{\text{Total Site Area}} = \frac{1337.90}{4700.00} = 0.28 < 2.00$$

NUMBER OF SEATING ARRANGEMENTS - 200

TOTAL BUILDING HEIGHT : 7.57 m

SANITATION REQUIREMENTS

MALE - 100 Nos / STAFF - 10Nos | FEMALE - 100 Nos / STAFF - 10 Nos

DESCRIPTION		REQUIRED	PROVIDED
WATER CLOSET	MALE (1 FOR 100 PERSONS UPTO 400 PERSONS)	1	2
	MALE STAFF (1 FOR 15 PERSONS)	1	1
	FEMALE (2 PER 100 PERSONS UPTO 200 PERSONS)	2	2
	FEMALE STAFF (1 FOR 1 TO 12 PERSONS)	1	1
	PH TOILET	1	1
URINAL	MALE (1 PER 50 PERSONS)	2	4
	STAFF (1 FOR 7 TO 20 PERSONS)	1	2
WASH BASIN	MALE (1 FOR EVERY 200 PERSONS)	1	1
	MALE STAFF (1 FOR 1 TO 15 PERSONS)	1	1
	FEMALE (1 FOR EVERY 200 PERSONS)	1	1
	FEMALE STAFF (1 FOR 1 TO 12 PERSONS)	1	1
DRINKING WATER	(1 PER 100 PERSONS)	4	6
BATH	1 PER 200 PERSONS	2	2

SPECIFICATION:-

. FOUNDATION	:	R.C.C COLUMN FOOTING 1:2:4 MIX OVER A BED OF C.C 1:5:10 MIX.
. BASEMENT	:	R.C.C COLUMN FOOTING 1:2:4 MIX, BRICK WORK IN C:M 1:6 MIX.
. SUPERSTRUCTURE	:	BRICK WORK IN C:M 1:6 MIX.
. ROOFING	:	R.C.C ROOF SLAB 1:2:4 MIX, 0.15M THICK AND GALVALUME SHEET
. FLOORING	:	C.C FLOORING 1:5:10 MIX 0.33 THICK AND TOP FINISHED WITH C:M 1:3 MIX, 0.23 TK.
. PLASTERING	:	CEMENT PLASTERING 1:5 MIX, 0.15 TK.
. USE	:	MARRIAGE HALL BUILDING.

JOINERIES		METER
D -	DOOR	1.83 X 2.44
D1 -	DOOR	1.22 X 2.44
D2 -	DOOR	0.91 X 2.44
D3 -	DOOR	0.76 X 2.13
S.D-	SLIDING DOOR	1.00 X 2.13
O -	OPEN	2.13 X 2.44
O1 -	OPEN	0.91 X 2.44
W -	WINDOW	1.52 X 1.83
W1-	WINDOW	1.37 X 1.68
W2-	WINDOW	1.22 X 1.53
W3-	WINDOW	1.07 X 1.53
W4-	WINDOW	0.91 X 1.53
W5-	WINDOW	0.60 X 1.53
V -	VENTILATOR	0.76 X 0.61

NOTE:-

1. L.P. GAS WILL BE USED FOR KITCHEN
2. BORE WELL WITH MOTOR, WATER TANK AND CORPORATION WATER SUPPLY WILL BE PROVIDED.
3. SULLAGE WASTE FROM TOILET WILL BE CONNECTED EXISTING
4. RAIN WATER PERCOLATION PITS OF 4NOS. PROVIDED @ 1/30 SQM OF PLINTH AREA @ 3M C/C
5. RAIN WATER PERCOLATION BED 1.0M WIDE WILL BE PROVIDED AROUND THE BUILDING AS PER GO (MS) NO. 138 DATED 11.02.02.
6. PERCOLATION BED OUT SIDE ALONG PLINTH TO BE PROVIDED
7. OUTER PAVEMENTS SLOPING TO WARDS RAIN WATER PERCOLATION PIT ALONG PLINTH
8. RAIN WATER TAKEN TO THE BORE WELL THROUGH 150MM DIA PIPES.
9. RAIN WATER COLLECTED FROM OPEN TERRACE SHALL BE COLLECTED THROUGH PIPES AND LED INTO A FILTER PIT (SIZE 60x60x60CM) WITH APPROPRIATE FILTER MATERIAL AND THEN LED INTO COLLECTION TANK.
10. SOLAR WATER HEATER LINE ARRANGMENTS WILL BE PROVIDED.
11. ALL DIMENSIONS ARE IN METRE.
12. AT KITCHEN EXHAUST FAN TO BE PROVIDED.
13. FA - FIRE ALARAM PROVIDED.
14. FE - FIRE SAFETY MEASURES PROVIDED.
15. SB - SAND BUCKET PROVIDED.
16. MECHANICAL VENTILATION TO BE PROPOSED.

STRUCTURAL ENGINEER

Er.S.SURENDAR, B.E., M.E. (Structures)
62, Alagampatti, Balakrishnapuram,
Dindigul - 624 005.
Mob : 63796 62087
REGISTERED STRUCTURAL ENGINEER
DINDIGUL LPA REG. No : SE 01/2023 (Gr-I)

CONSTRUCTION ENGINEER


Er.J.JEYAWILSON, B.E., M.E.,
Registered Construction Engineer
DLPA Reg. No: CE 02/2025 (DTCP)
HI-TECH PROMOTERS, HANIN TOWERS
Annamalaiyar School Road,
Near Roundana, Nagal Nagar,
Dindigul - 624 003. Cell : 96779 12666

REGISTERED ENGINEER

Er. P. ANBAZHAGAN, B.E.,M.C.E.,F.I.V.,
Chartered Engineer and Valuer,
DLPA-RE 01/2025(GR-I) & RSE04/2024(GR-II),
16, VIVEKANANDA NAGAR, DINDIGUL.
CELL : 91501 69343

APPLICANT

SITE PLAN
(SCALE 1:400)

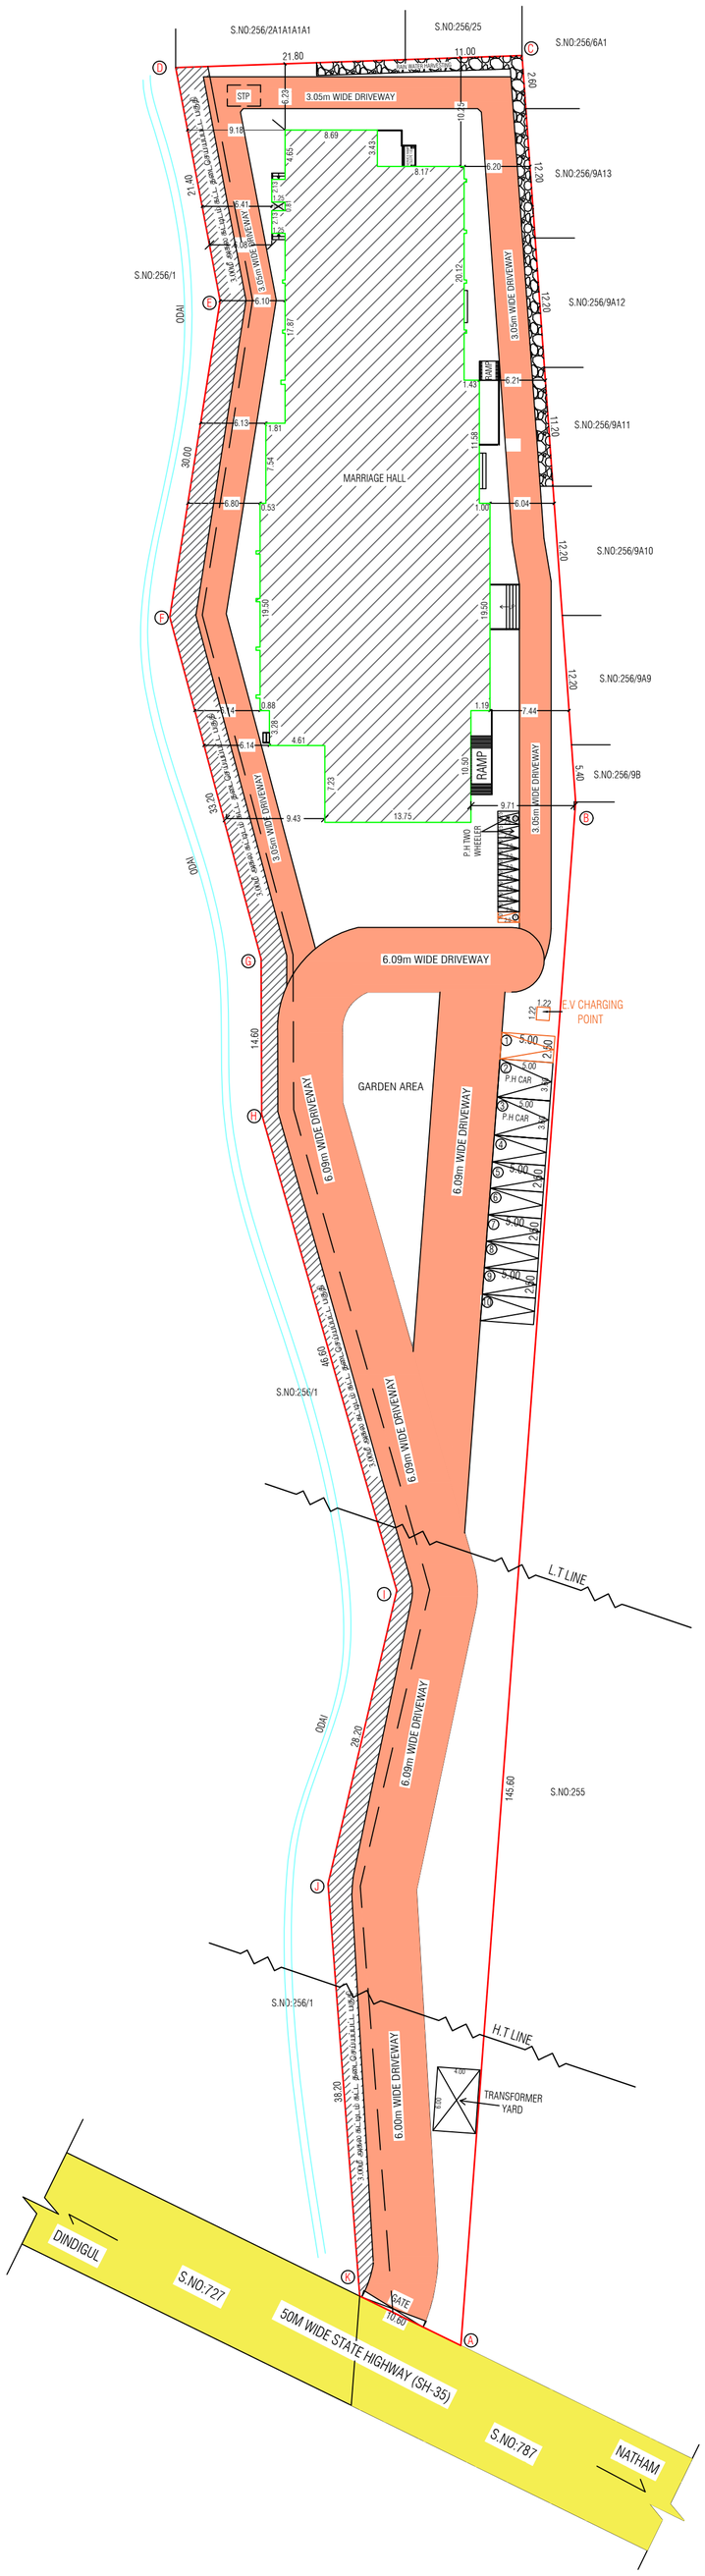

SHEET No : 3/3

REVISED SITE PLAN SHOWING THE PROPOSED CONSTRUCTION OF MARRIAGE HALL BUILDING IN S.F.NO: 256/8 AT THOTTANUTHU VILLAGE & PANCHAYAT, DINDIGUL EAST TALUK, DINDIGUL DISTRICT.

All Dimensions Are In Meters
. SCALE : [1:400]

N
W – E
S

EXISTING APPROVAL DETAILS:

Online Application No : SWP/BPA/740227/2025 (Date : 20.01.2026)

Site Boundary Shown as "A to K" And Numbered as

BUILDING PERMISSION :

Numbered As: SWP/DTCP/ Dindigul /
BUILDING PERMISSION NO : 02/2026 (Date : 20.01.2026)

PLANNING PERMISSION :

Numbered As: SWP/DTCP/ Dindigul /
PLANNING PERMISSION NO : 06/2026 (Date : 20.01.2026)

REVISED APPROVAL DETAILS:

Online Application No : SWP/BPA/890792/2026 (Date : 04.07.2026)

Site Boundary Shown as "A to K" And Numbered as

BUILDING PERMISSION :

Numbered As: SWP/DTCP/ Dindigul /
BUILDING PERMISSION NO : 39/2026

PLANNING PERMISSION :

Numbered As: SWP/DTCP/ Dindigul /
PLANNING PERMISSION NO : 39/2026

SITE AREA DETAILS :-

SURVEY.NO	AS PER DOCUMENT	AS PER PATTA
256 / 8	4700.00 SQ.MT	4700.00 SQ.MT

PROPOSED BUILDING AREA DETAILS :-

DESCRIPTION	FSI sq.mt	NON - FSI sq.mt	TOTAL sq.mt
GROUND FLOOR AREA	1177.00	---	1177.00
FIRST FLOOR AREA	160.90	---	160.90
TERRACE FLOOR AREA	---	35.01	35.01
TOTAL	1337.90	35.01	1372.91

$$\text{FSI} = \frac{\text{Total FSI Area}}{\text{Total Site Area}} = \frac{1337.90}{4700.00} = 0.28 < 2.00$$

NUMBER OF SEATING ARRANGEMENTS - 200

TOTAL BUILDING HEIGHT : 7.57 m

PARKING DETAILS:-

PANCHAYAT AREAS:-

1 CAR SPACE AND 1 TWO WHEELER SPACE FOR THE EVERY 50SQ.M OF AUDITORIUM / KALYANA MANDAPAM AREA OR PART THEREOF

$$\text{PARKING CALCULATION} = \frac{(\text{MARRIAGE HALL AREA})}{50} = \frac{390.26}{50} = 8 \text{ No's}$$

DESCRIPTION		REQUIRED	PROVIDED	TOTAL
CAR PARKING	NORMAL CAR	6	7	10
	PHYSICAL CHALLENGED	1	2	
	ELECTRIC VECHICLE	1	1	
TWO WHEELER PARKING	NORMAL TWO WHEELER	6	7	10
	PHYSICAL CHALLENGED	1	2	
	ELECTRIC VECHICLE	1	1	

SANITATION REQUIREMENTS

MALE - 100 Nos / STAFF - 10Nos | FEMALE - 100 Nos / STAFF - 10 Nos

DESCRIPTION		REQUIRED	PROVIDED
WATER CLOSET	MALE (1 FOR 100 PERSONS UPTO 400 PERSONS)	1	2
	MALE STAFF (1 FOR 15 PERSONS)	1	1
	FEMALE (2 PER 100 PERSONS UPTO 200 PERSONS)	2	2
	FEMALE STAFF (1 FOR 1 TO 12 PERSONS)	1	1
	PH TOILET	1	1
URINAL	MALE (1 PER 50 PERSONS)	2	4
	STAFF (1 FOR 7 TO 20 PERSONS)	1	2
WASH BASIN	MALE (1 FOR EVERY 200 PERSONS)	1	1
	MALE STAFF (1 FOR 1 TO 15 PERSONS)	1	1
	FEMALE (1 FOR EVERY 200 PERSONS)	1	1
	FEMALE STAFF (1 FOR 1 TO 12 PERSONS)	1	1
DRINKING WATER	(1 PER 100 PERSONS)	4	6
BATH	1 PER 200 PERSONS	2	2

REFERENCE:-

- SITE BOUNDARY
- PROPOSED BUILDING
- DRIVE WAY
- EXISTING ROAD
- RWH TRENCH
- LT/HT LINE

STRUCTURAL ENGINEER

Er.S.SURENDAR, B.E., M.E. (Structural)
62, Alagampatti, Balakrishnapuram,
Dindigul - 624 005.
Mob : 63796 82087
REGISTERED STRUCTURAL ENGINEER
DINDIGUL LPA REG.No : SE 01/2023 (Gr-I)

CONSTRUCTION ENGINEER

Er.J.JEYAWILSON, B.E., M.E.,
Registered Construction Engineer
DLPA Reg. No: CE 02/2025 (DTCP)
HI-TECH PROMOTERS, HANIN TOWERS
Annamalaiyar School Road,
Near Roundana, Nagal Nagar,
Dindigal - 624 003. Cell : 96779 12666

E-SIGNED

DISTRICT DIRECTOR,
DISTRICT TOWN AND COUNTRY PLANNING,
DINDIGUL DISTRICT.

REGISTERED ENGINEER

Er. P. ANBAZHAGAN, B.E.,M.C.E.,F.I.V.,
Chartered Engineer and Valuer,
DLPA-RE 01/2025(GR-I) & RSE 04/2024(GR-II),
16, VIVEKANANDA NAGAR, DINDIGUL.
CELL : 91501 69343

APPLICANT

THE LANDLENS SUITE

Eight ways to know a piece of land before you pay for it.

This report covers one part of the picture. These cover the rest, drawn from the same government records, for any property in Tamil Nadu.

LandLens One
Ask anything about a property and get an answer grounded in live government records, with the sources shown.
/landlens/one

Verify My Land
Every record check run on one property and returned as a single report.
/landlens/verify-my-land

Legal Opinion
An advocate's written opinion on the title, built on the records we pull for it.
/landlens

One Map
Every layer on one map: the parcel, its boundary, zoning, water bodies and what sits around it.
/landlens/one/map

PriceMap
What land actually changed hands for around this plot, taken from the registered deeds.
/landlens/pricemap

Build Scope
What you are allowed to build here: floor space, height, coverage and setbacks.
/landlens/build-scope

Property Tracker
Watch a property and hear about it when something new is registered against it.
/landlens/property-tracker

Deal Room
Run the transaction in one place: documents, stamping, signatures and the parties.
/landlens/deal-room

FREE TOOLS · NO ACCOUNT NEEDED

Twenty-four checks you can run yourself, at no cost.

Records and verification

The registers themselves, read for you.

- Encumbrance Certificate
- Patta and Chitta
- Field Measurement Sketch
- EC Analyzer
- Bank charge check
- Court case search
- Seller background check
- Approval check by survey

Value and duty

What it is worth and what it costs to register.

- Guideline value by street
- Guideline value by survey
- Stamp duty and registration fees
- Capital gains
- Floor space index
- Area unit converter

Zoning and land use

What the plan says can happen on this land.

- Land use zone finder
- CMDA land use check
- Coastal regulation zone
- Master plan check
- Water bodies finder
- Airport height clearance

Registers and directories

Who holds it, and which office keeps the record.

- Find your registering office
- Temple property check
- Waqf property check
- RERA register

Every free tool
/tools

Services we run for you
/services

The LandLens suite
/landlens/one

Verified RealEstate™

Every claim in this document traces back to a government record.

- Legal opinions, due diligence and title verification
- Building plan, layout and sub-division approvals
- Completion and occupancy certificates, regularisation
- Escrow, negotiation and NRI property management
- Land survey, soil testing, architecture and construction

Verified RealEstate
3/350/2 Mettukuppam,
OMR Thoraipakkam,
Chennai 600 097, India
hello@verified.realestate
+91 9996 12 9996

Prepared from the registers named on the page each finding sits on. Where a register could not be read, this document says so in its place rather than leaving the gap to be read as a clean result.