

RE

REGULATORY RECORD

RERA Document

The document as the regulator published it, reproduced in full behind this page.

Published for reference. The authority's own register is the operative record.

REVISED SITE PLAN SHOWING THE PROPOSED ADDITIONAL CONSTRUCTION OF MULTI STOREY BUILDING [STILT + 7 FLOORS]

AND REVISED SPECIAL BUILDING BLOCKS AS ON GROUND REALITY IN S.F. Nos : 16/4A, 16/4B, 65/4, 65/5A, 65/5B, 76/4, 76/5,

77/1 A, 77/1B, 77/2B, 77/2C [A,B,C,D,E,F], 77/2C2, 77/3A, 77/3B, 78/1, 78/2, 79/1, 79/2, 80/1, 80/2, 81/1, 81/2, 82, 83, 85, 86/1B,

86/1C, 86/2A, 86/2B, 87/1A, 87/1B, 87/1B2, 87/2A, 87/2B, 87/2C, 88/1, 88/2, 88/3, 89/2, 89/3 A, 89/3 B, 89/3C, 89/4 A, 89/4B, 90, 95/4,

PERUMATTUNALLUR VILLAGE, CHENGALPATTU TALUK, KANJIPURAM DISTRICT. (Revision sought for DTP Approval in

Roc No.: 15592 / 2009 / SC dt 07-12-2009 and Chengalattu RDD Roc No.: 1586 / 09 CR 7 dated 26-02-2010).

SHEET NO : 1 / 35

SCALE 1 : 400

AREA DETAILS :-
All Details are given in Sq. m

DESCRIPTION	STILT FLOOR	GROUND FLOOR	FIRST FLOOR	SECOND FLOOR	THIRD FLOOR	FOURTH FLOOR	FIFTH FLOOR	SIXTH FLOOR	SEVENTH FLOOR	TERRACE FLOOR	LIFT SHAFT	NO. OF FLATS	TOTAL	FIRE ESCAPE	Car Parking	Required	Provided	Open	Wheelers

S.F. NO. 77/2A

S.F. NO. 65/2

S.F. NO. 65/1

S.F. NO. 65/3

S.F. NO. 76/3

S.F. NO. 17

S.F. NO. 16/4C

S.F. NO. 84


























































































PLAN SHOWING PROPOSED ADDITIONAL CONSTRUCTION OF MULTI STOREY BUILDING [STILT+7 FLOORS] IN S.F. Nos : 16/4A, 16/4B, 65/4, 65/5A, 65/5B, 76/4, 76/5, 77/1 A, 77/1B, 77/2B, 77/2C1[A,B,C,D,E,F], 77/2C2, 77/3A, 77/3B, 78/1, 78/2, 79/1, 79/2, 80/1, 80/2, 81/1, 81/2, 82, 83, 85, 86/1B, 86/1C, 86/2A, 86/2B, 87/1A, 87/1B1, 87/1B2, 87/2A, 87/2B, 87/2C, 88/1, 88/2, 88/3, 89/2, 89/3 A, 89/3B, 89/3C, 89/4 A, 89/4B, 90, 95/4, PERUMATTUNALLUR VILLAGE, CHENGALPATTU TALUK, KANJIPURAM DISTRICT.
(Revision sought for DTCP Approval in Roc No.: 15592 / 2009 / SC dt 07-12-2009 and Chengalattu RDD Roc No.: 1586 / 09 CR 7 dated 26-02-2010).

PROPOSED APARTMENT COMPLEX - Typical Towers 11&8 LIG

ALL MEASUREMENTS ARE IN METRE

FLAT AREA DETAILS:

DESCRIPTION	TYPICAL TOWERS 8 (EWS)		
	No. of flats	Area in Sq m	Car Parking Req.
FLATS IN FIRST FLOOR - 1 TO 16	16 x 2	42.21 (Each)	Nil
FLATS IN SECOND FLOOR - 1 TO 16	16 x 2	42.21 (Each)	Nil
FLATS IN THIRD FLOOR - 1 TO 16	16 x 2	42.21 (Each)	Nil
FLATS IN FOURTH FLOOR - 1 TO 16	16 x 2	42.21 (Each)	Nil
FLATS IN FIFTH FLOOR - 1 TO 16	16 x 2	42.21 (Each)	Nil
FLATS IN SIXTH FLOOR - 1 TO 16	16 x 2	42.21 (Each)	Nil
FLATS IN SEVENTH FLOOR - 1 TO 16	16 x 2	42.21 (Each)	Nil
TOTAL	224 Flats		
REQUIRED CAR PARKING :	Nil		
PROVIDED (Covered Parking)	8 x 2 = 16 Nos	Two Wheeler Parking : 57 x 2 = 114 Nos	

AREA DETAILS:

DESCRIPTION	TOWER 8 (LIG)		TOWER 11 (LIG)		TOTAL	
	F.S.I. AREA	NON - F.S.I. AREA	F.S.I. AREA	NON - F.S.I. AREA	F.S.I. AREA	NON - F.S.I. AREA
STILT FLOOR	777.56	777.56	777.56	777.56	1555.12	1555.12
FIRST FLOOR	777.56	777.56	777.56	777.56	1555.12	1555.12
SECOND FLOOR	777.56	777.56	777.56	777.56	1555.12	1555.12
THIRD FLOOR	777.56	777.56	777.56	777.56	1555.12	1555.12
FOURTH FLOOR	777.56	777.56	777.56	777.56	1555.12	1555.12
FIFTH FLOOR	777.56	777.56	777.56	777.56	1555.12	1555.12
SIXTH FLOOR	777.56	777.56	777.56	777.56	1555.12	1555.12
SEVENTH FLOOR	777.56	777.56	777.56	777.56	1555.12	1555.12
TERRACE FLOOR	52.10	52.10	52.10	52.10	104.20	104.20
LIFTWELL	10.81	10.81	10.81	10.81	21.62	21.62
ELECTRICAL ROOM	28.16	28.16	28.16	28.16	56.32	56.32
BALCONY	304.50	304.50	304.50	304.50	609.00	609.00
FIRE ESCAPE STAIR	113.12	113.12	113.12	113.12	226.24	226.24
TOTAL	5442.92	1286.65	5442.92	1286.65	10885.84	2572.48
TOTAL No. OF FLATS	224 Flats		224 Flats		448 Flats	

For Shrip Structures Pvt. Ltd.

Authorized Signatory


APPLICANT:

STRUCTURAL ENGINEER


ARCHITECT / LICENSED BUILDING SURVEYOR:

S. MURUGESAN, M.E.
REGISTERED ENGINEER AM-02226


T.S. RAMANATHAN, ARCH. ELLA.
REGISTERED ARCHITECT
L.S. GRADE-I
L.S. ARCHITECT No. 773754

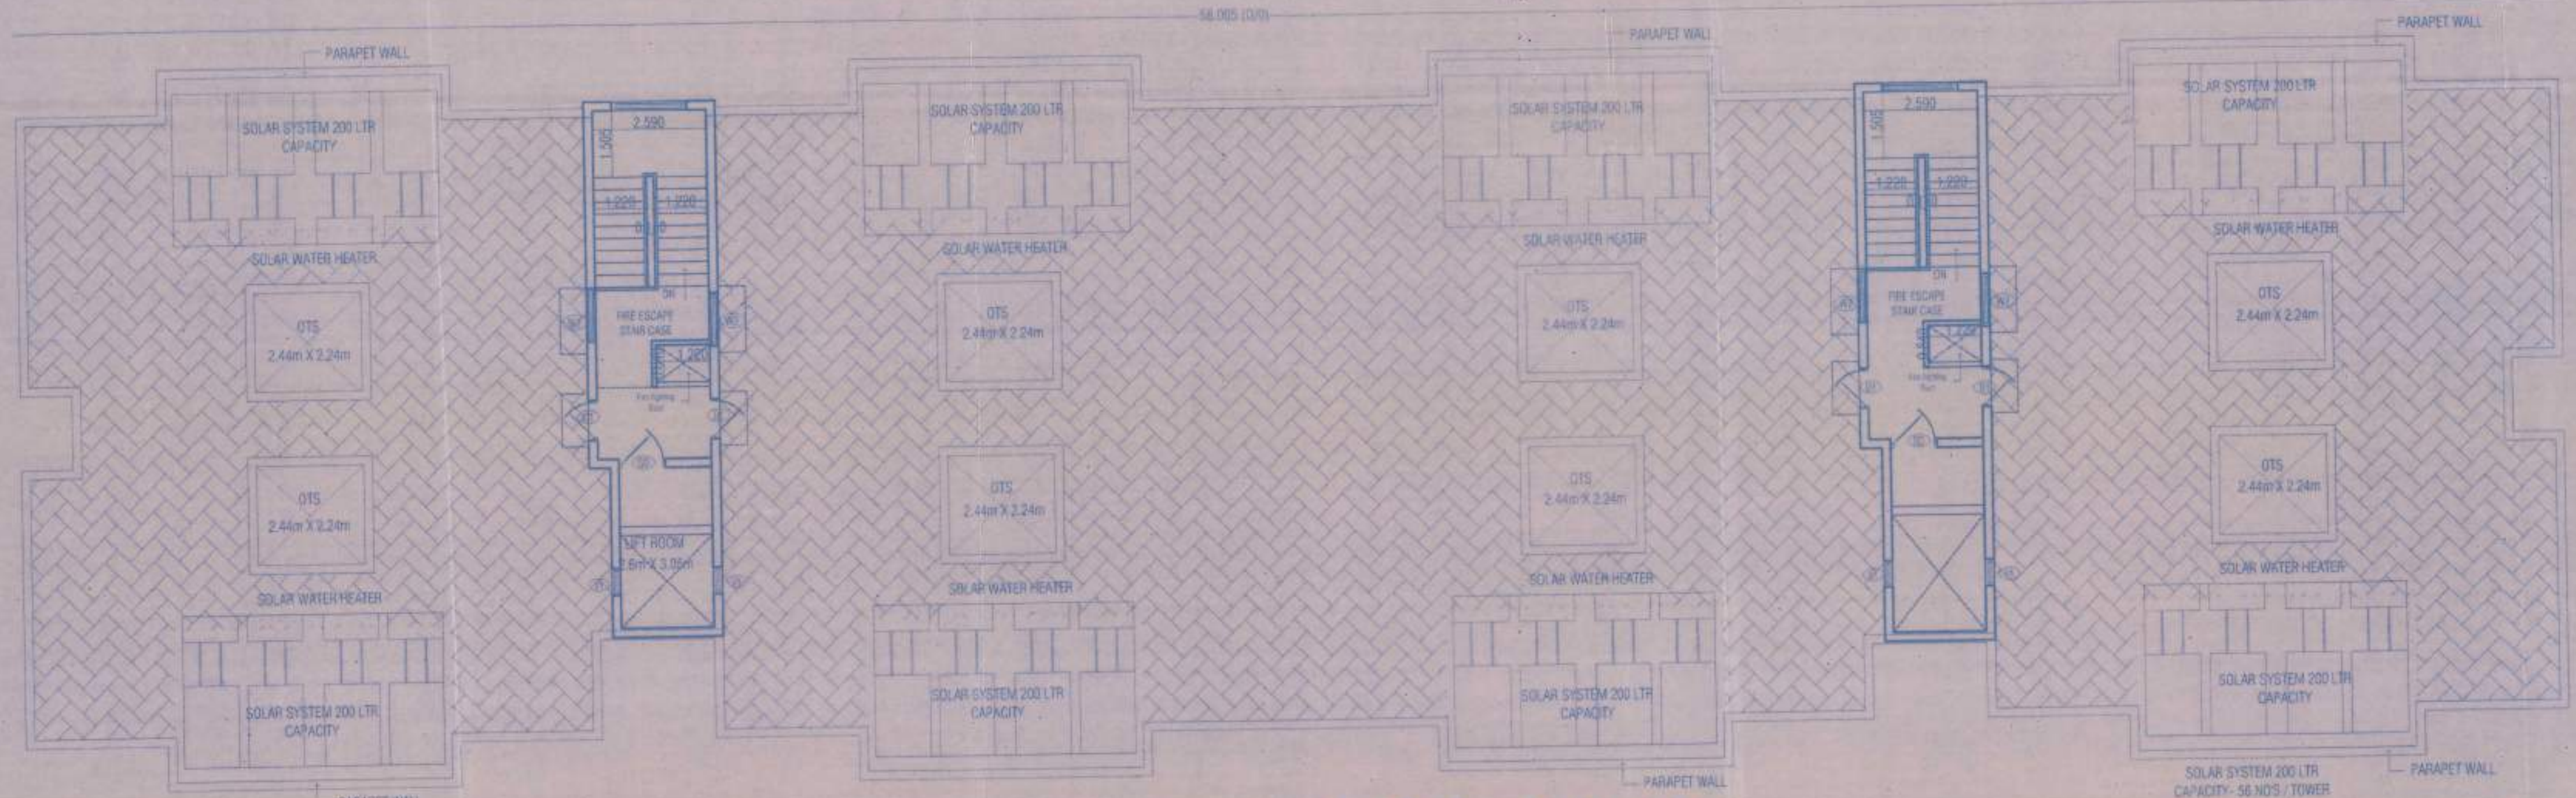


TERRACE FLOOR PLAN FOR TYPICAL TOWERS - 8 (EWS) & 11

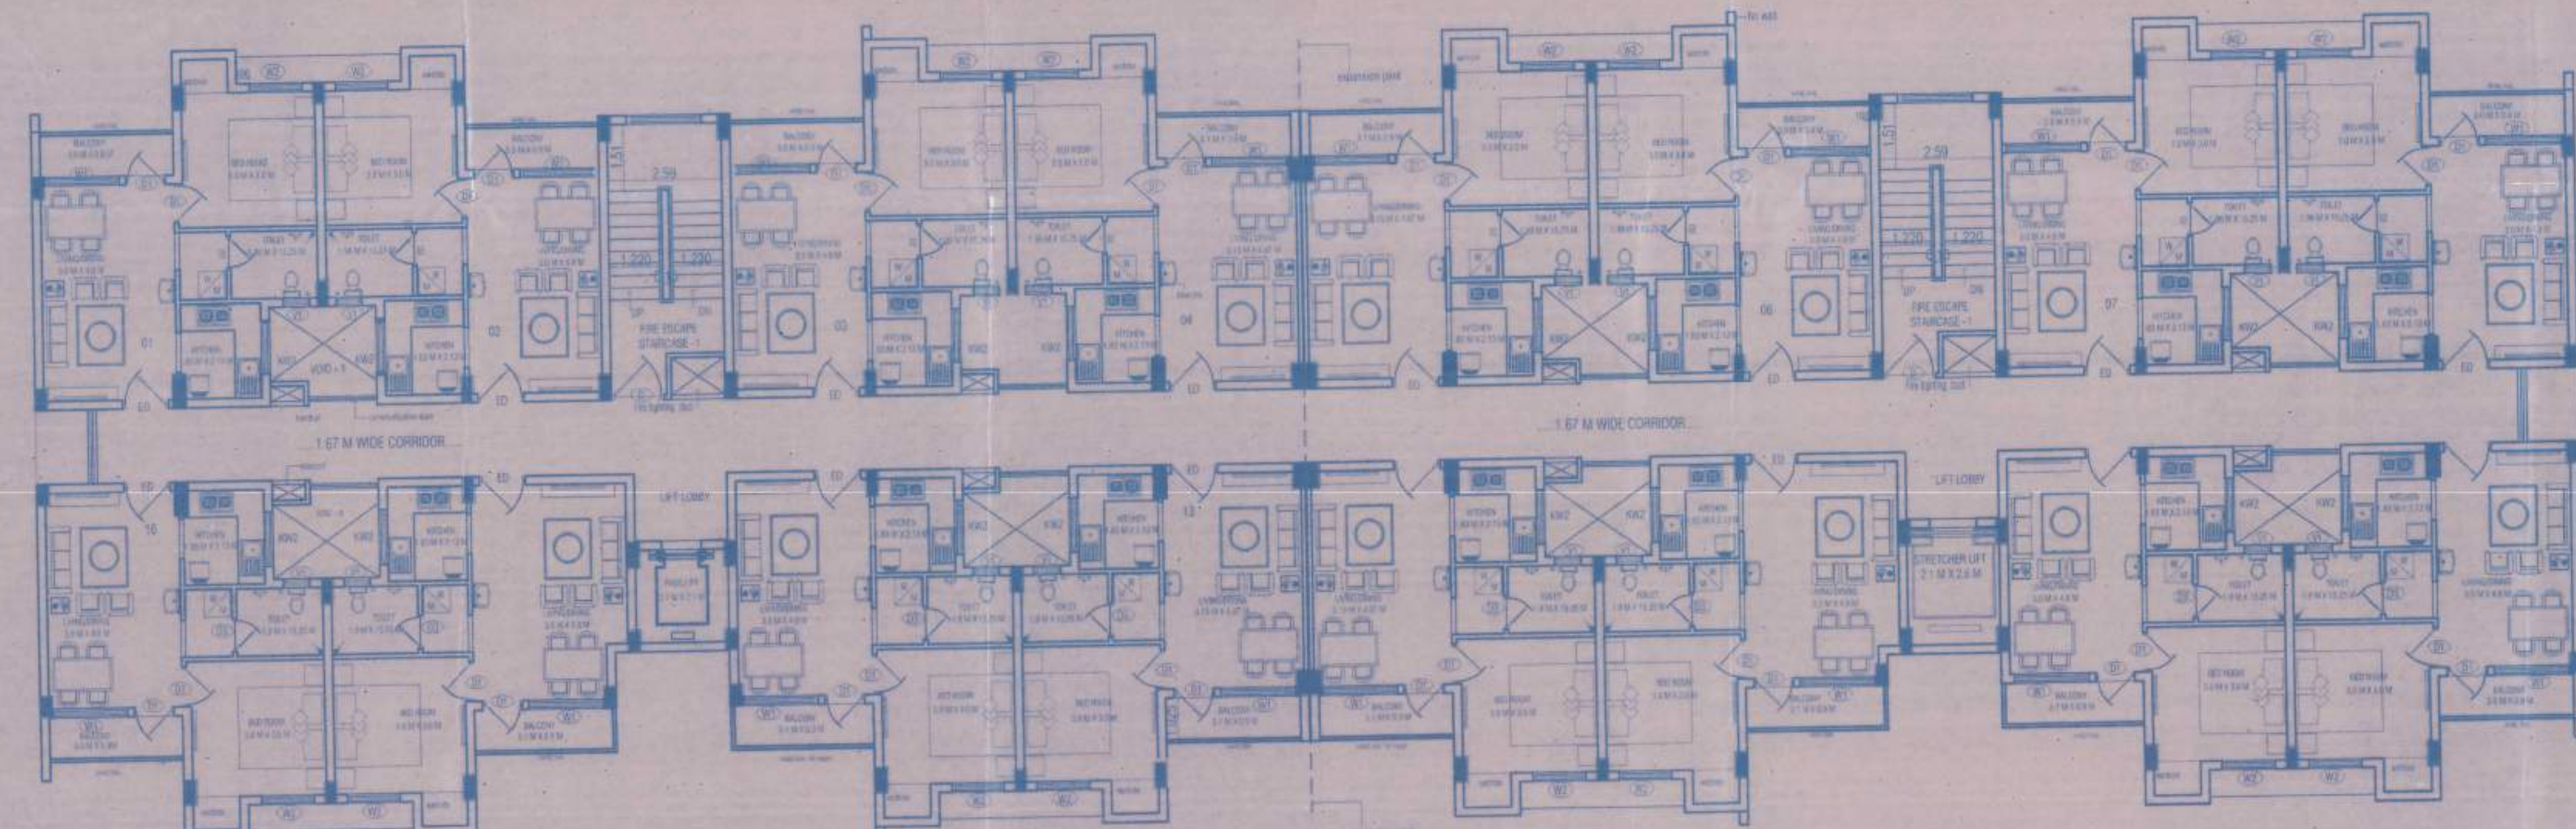


TYPICAL PLAN FOR FIRST, SECOND, THIRD, FOURTH, FIFTH, SIXTH & SEVENTH FLOOR FOR TYPICAL TOWERS - 8 (EWS) & 11

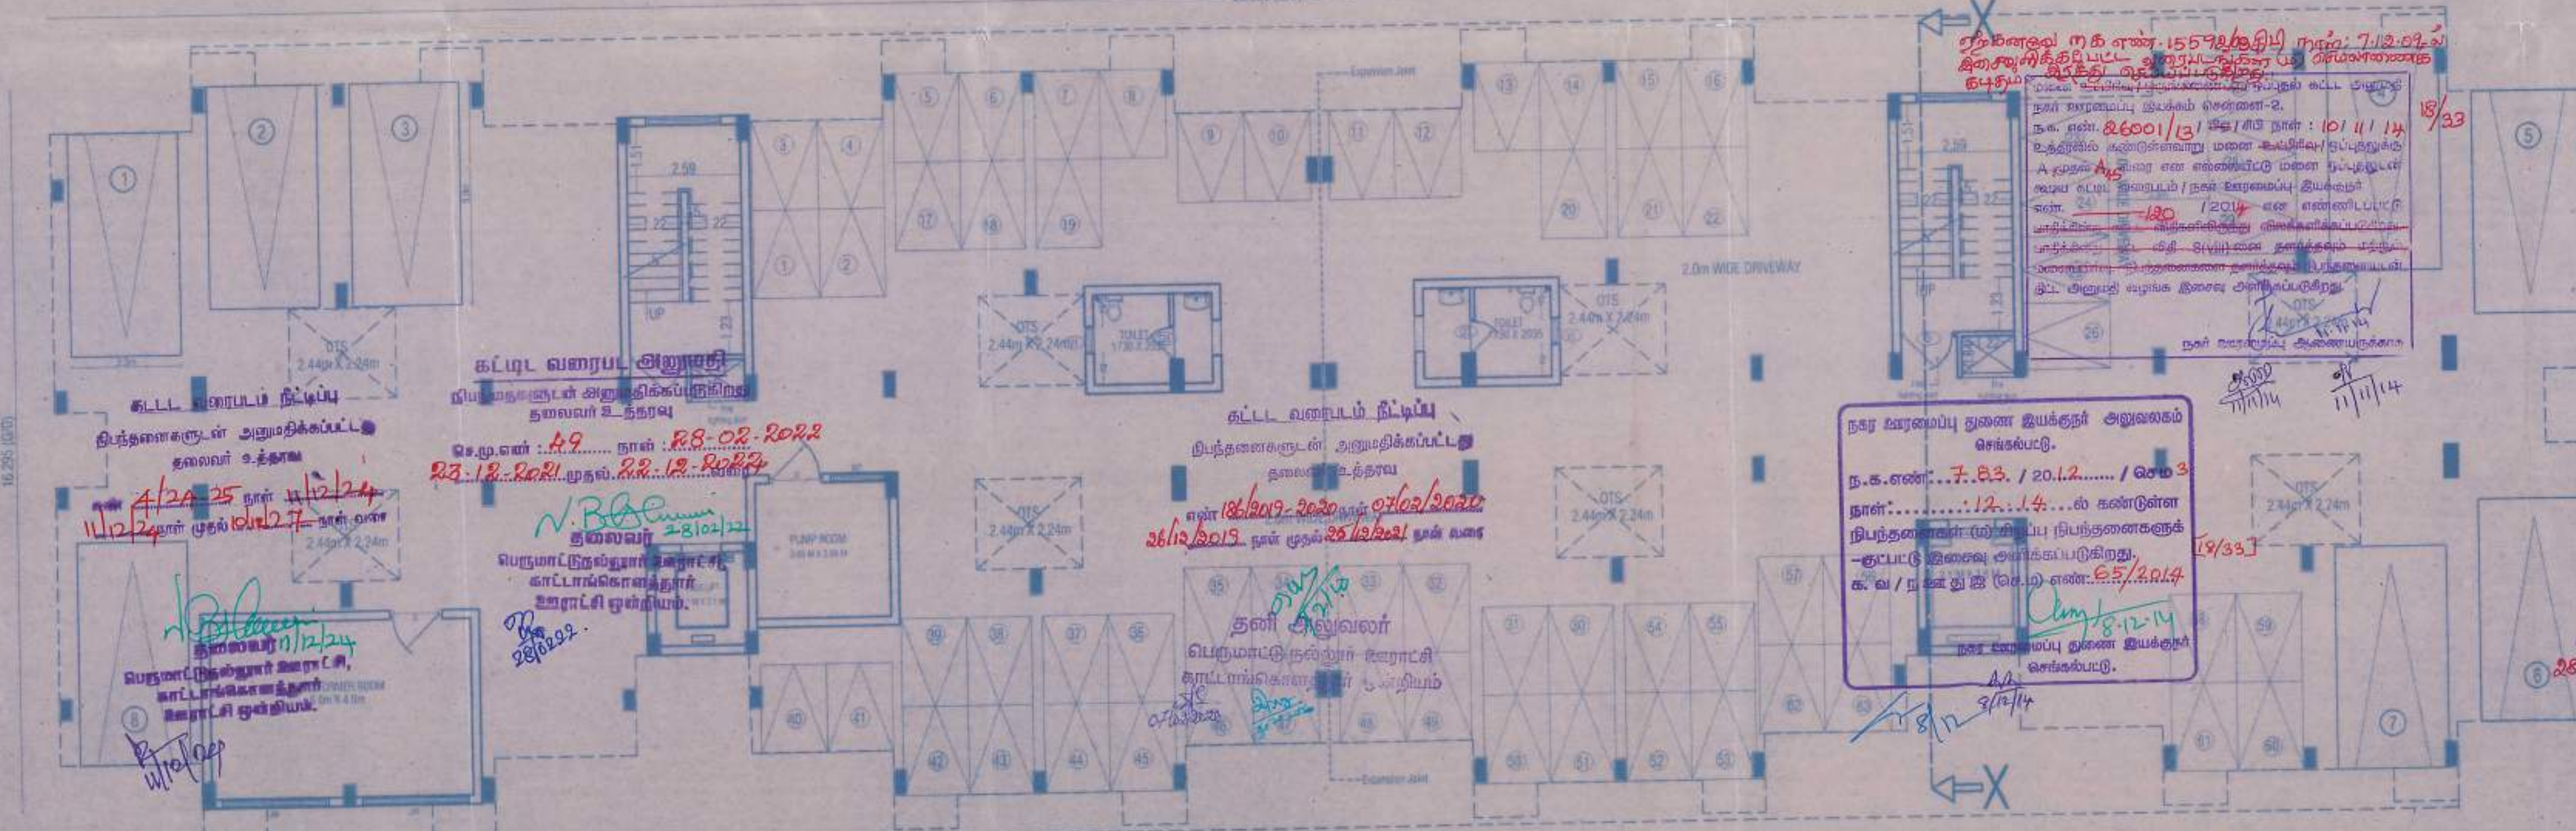


STILT FLOOR FOR TYPICAL TOWERS - 8 (EWS) & 11

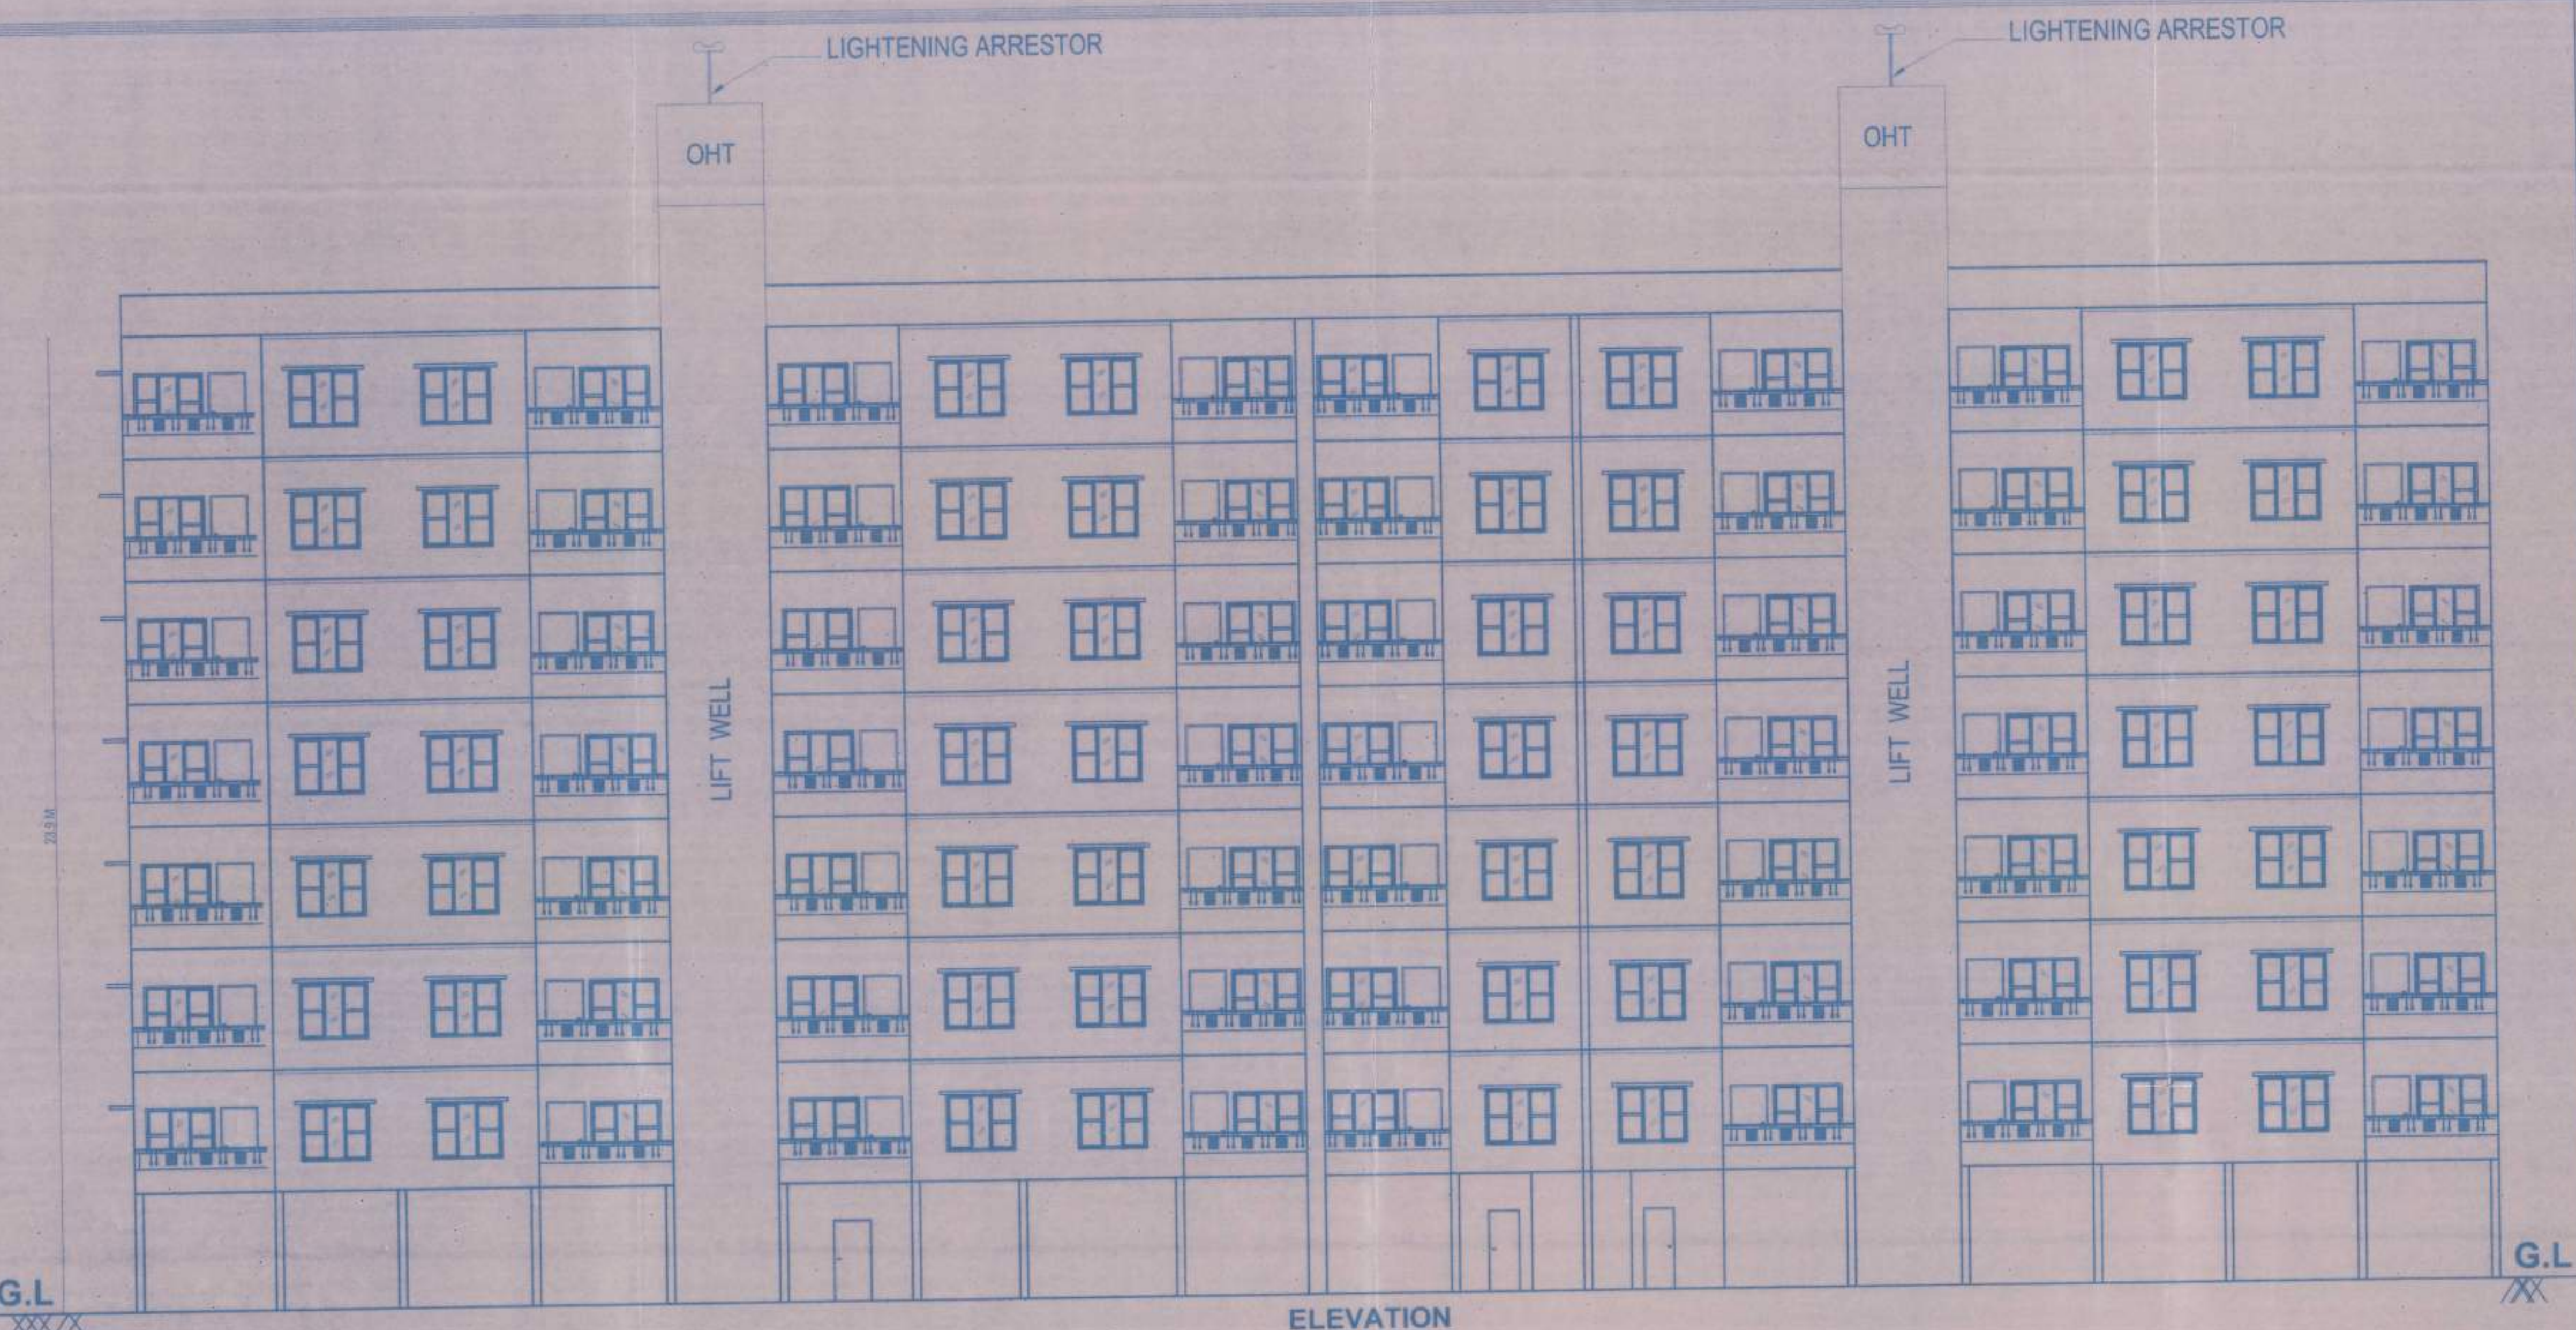

ELEVATION

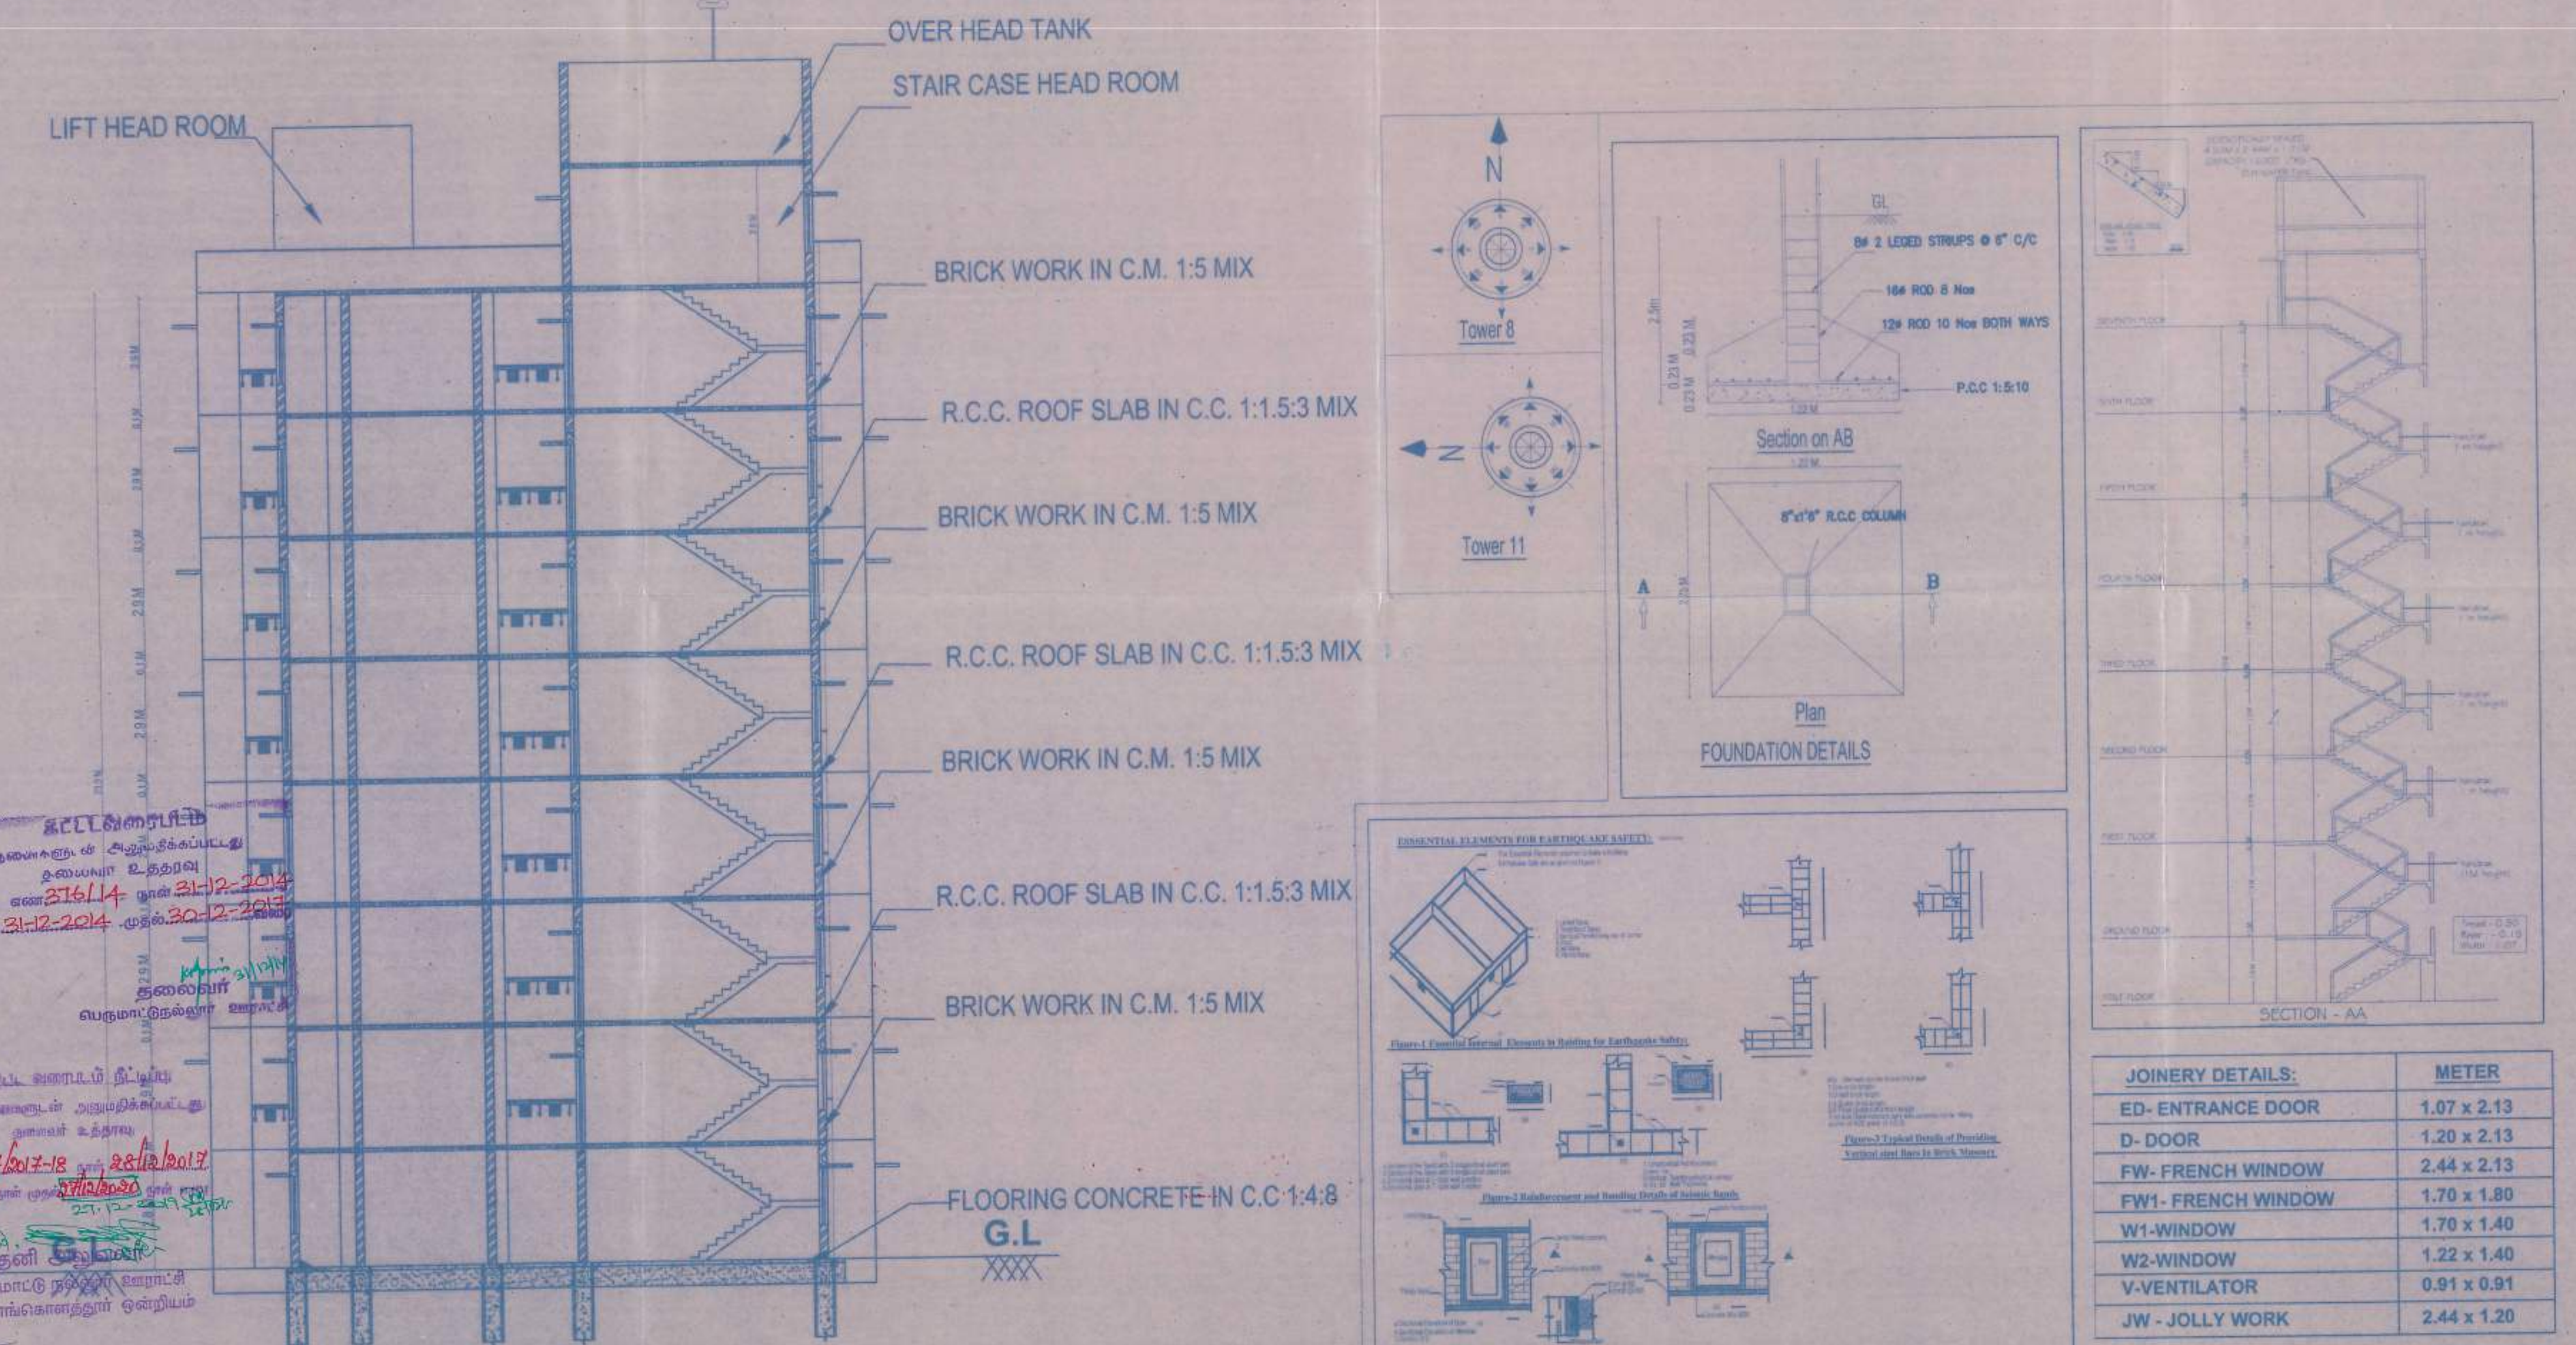

SECTION ON 'X-X'

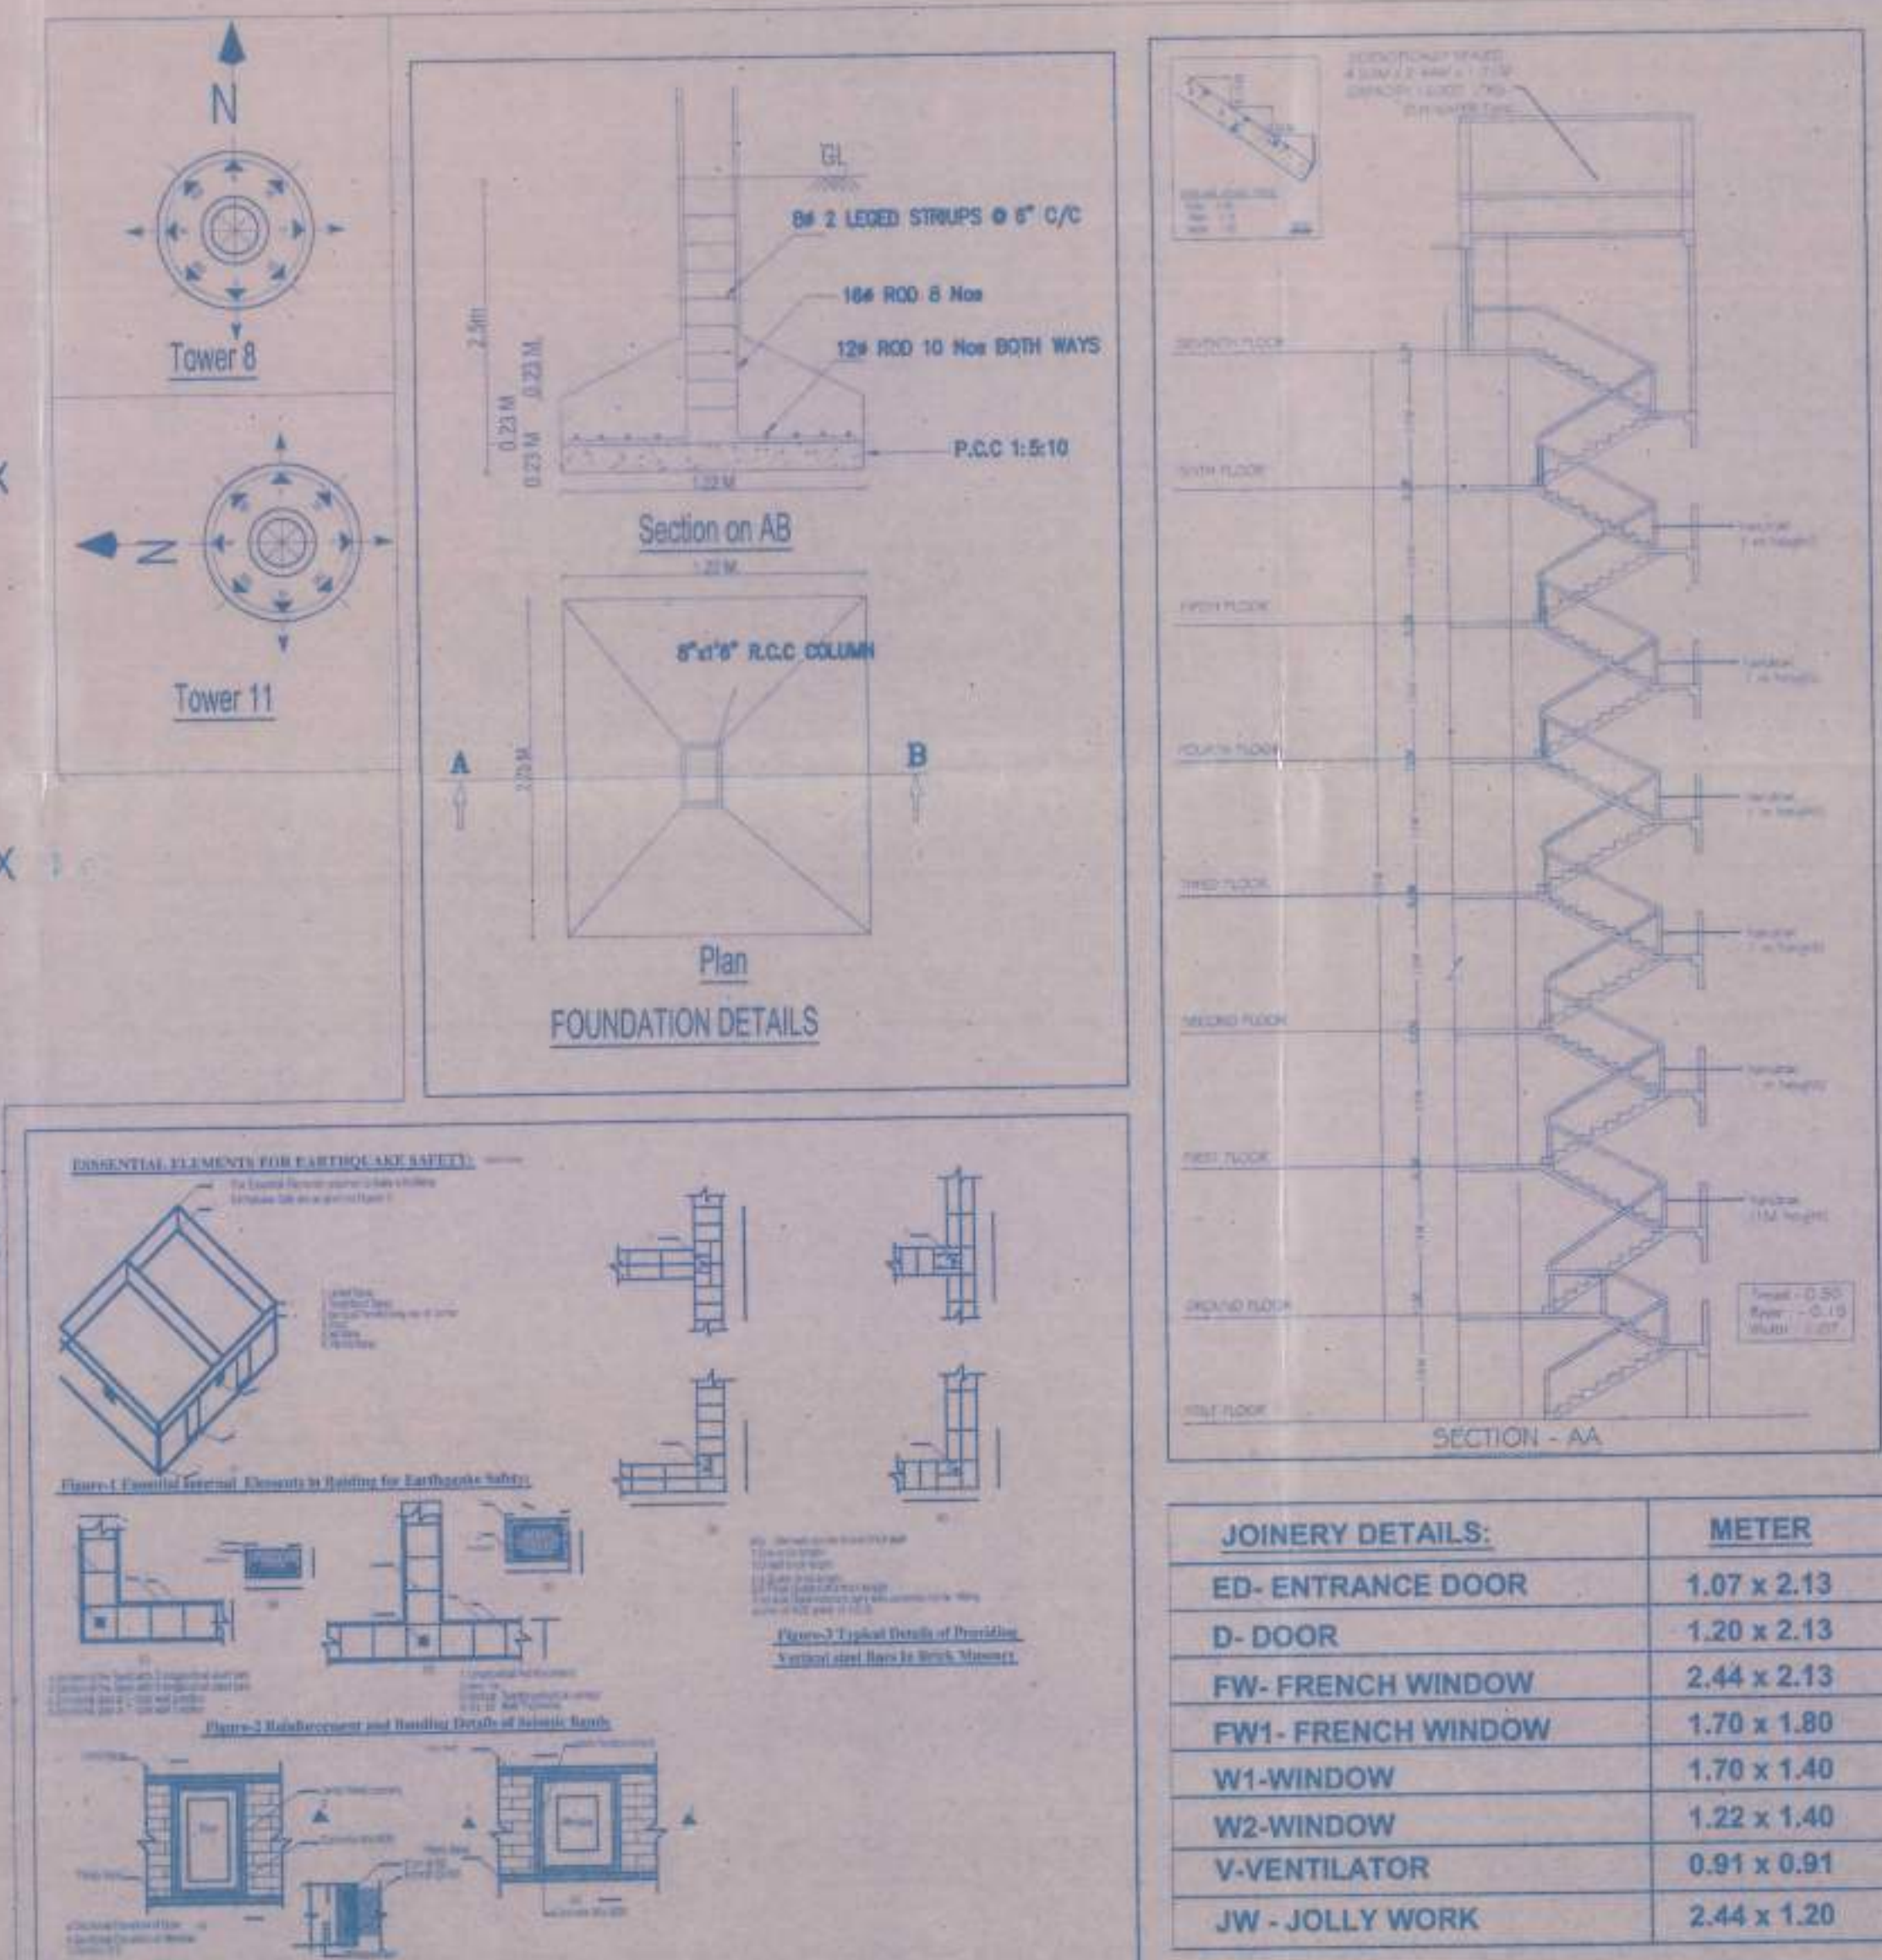

FOUNDATION DETAILS

JOINERY DETAILS:	METER
ED- ENTRANCE DOOR	1.07 x 2.13
D- DOOR	1.20 x 2.13
FW- FRENCH WINDOW	2.44 x 2.13
FW1- FRENCH WINDOW	1.70 x 1.80
W1-WINDOW	1.70 x 1.40
W2-WINDOW	1.22 x 1.40
V-VENTILATOR	0.91 x 0.91
JW- JOLLY WORK	2.44 x 1.20

Eight ways to know a piece of land before you pay for it.

This report covers one part of the picture. These cover the rest, drawn from the same government records, for any property in Tamil Nadu.

LandLens One

Ask anything about a property and get an answer grounded in live government records, with the sources shown.

[/landlens/one](#)



Verify My Land

Every record check run on one property and returned as a single report.

[/landlens/verify-my-land](#)



Legal Opinion

An advocate's written opinion on the title, built on the records we pull for it.

[/landlens](#)



One Map

Every layer on one map: the parcel, its boundary, zoning, water bodies and what sits around it.

[/landlens/one/map](#)



PriceMap

What land actually changed hands for around this plot, taken from the registered deeds.

[/landlens/pricemap](#)



Build Scope

What you are allowed to build here: floor space, height, coverage and setbacks.

[/landlens/build-scope](#)



Property Tracker

Watch a property and hear about it when something new is registered against it.

[/landlens/property-tracker](#)



Deal Room

Run the transaction in one place: documents, stamping, signatures and the parties.

[/landlens/deal-room](#)



Twenty-four checks you can run yourself, at no cost.

Records and verification

The registers themselves, read for you.

Encumbrance Certificate

Patta and Chitta

Field Measurement Sketch

EC Analyzer

Bank charge check

Court case search

Seller background check

Approval check by survey

Zoning and land use

What the plan says can happen on this land.

Land use zone finder

CMDA land use check

Coastal regulation zone

Master plan check

Water bodies finder

Airport height clearance

Value and duty

What it is worth and what it costs to register.

Guideline value by street

Guideline value by survey

Stamp duty and registration fees

Capital gains

Floor space index

Area unit converter

Registers and directories

Who holds it, and which office keeps the record.

Find your registering office

Temple property check

Waqf property check

RERA register



Every free tool
/tools



Services we run
for you
/services



The LandLens
suite
/landlens/one



Every claim in this document traces back to a government record.

Legal opinions, due diligence and title verification

Building plan, layout and sub-division approvals

Completion and occupancy certificates, regularisation

Escrow, negotiation and NRI property management

Land survey, soil testing, architecture and construction

Verified RealEstate
3/350/2 Mettukuppam,
OMR Thoraipakkam,
Chennai 600 097, India
hello@verified.realestate
+91 9996 12 9996

Prepared from the registers named on the page each finding sits on. Where a register could not be read, this document says so in its place rather than leaving the gap to be read as a clean result.

